

KANSAS

FORM 51 5M 10-41 PETROL


Rice

Section 25 Township 20 Range 6-W

Well No. #3 Hodge

Company Westgate Greenland

Bornholdt Pool

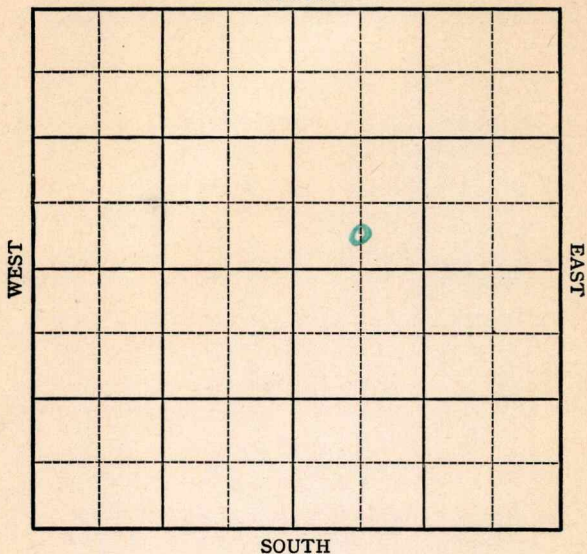

Rice

KANSAS

Map No. 4P Sec. 25 Twp. 20 R. 6WWell No. 3 HodgeWestgate Greenland CompanyFIRST REPORT Contractor

C SL SW NE

SECTION PLAT

		o	

 Ft. from N. Line330 Ft. from S. Line Ft. from E. Line660 Ft. from W. Line

BORNHOLDT POOL

RECORD

Location Cased in., ft.Rig up Sand

Drilling and Remarks:

Gas

Derrick

Oil Total Depth

PRODUCTION

1st 24 hrs. Nat. 1st 24 hrs. after shot Gas Cu. Ft.Dry Hole Abandoned

Date

MAR 25 1942 19S. J. LEWIS Scout

Rice

KANSAS

Map No. 48 Sec. 25 Twp. 20 R. 6WWell No. 3 HodgeWestgate Greenland Company**ABANDONED** Contractor

C SL SW NE

SECTION PLAT

 Ft. from N. Line330 Ft. from S. Line Ft. from E. Line660 Ft. from W. LineBORNHOLDT POOLLocation Rig up

Drilling and Remarks:

Was 32752" @ 3276Water

RECORD

Cased in., ft.Sand Gas Oil Total Depth 3279

PRODUCTION

1st 24 hrs. Nat. 1st 24 hrs. after shot Gas Cu. Ft.Dry Hole Abandoned

Date

APR 29 1942 19S. J. LEWIS Scout