


Rice

Section 25 Township 20 Range 6-W

Well No. #4 Hodge

Company W. C. McBride

NORTH Bornholdt Pool

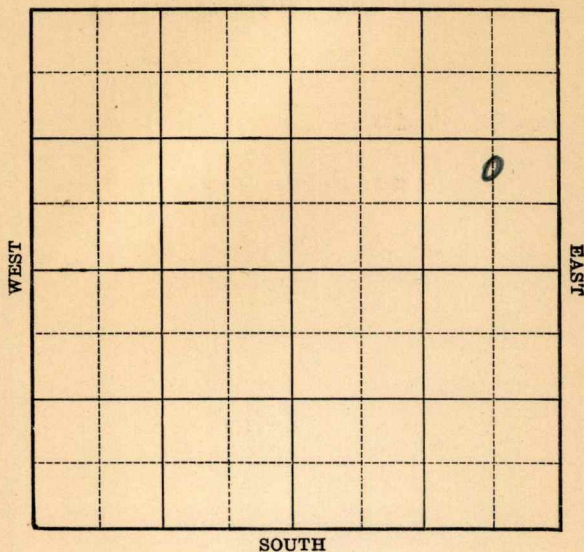

KANSAS


Rice

Sec. 25 Twp. 20 R. 6-WWell No. #4 Hodge FarmW. C. McBride Company

(Bornholdt)

 Ft. from N. Line990 Ft. from S. Line660 Ft. from E. Line Ft. from W. Line

Elev. 1525

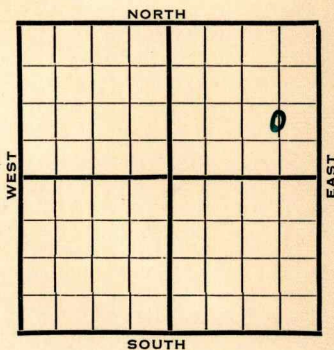

1940

REPORT

5/1 Rigging up rotary.

5/9 13" - 115' Drlg. 2470'

5/16 Chat. 3292-95' T.D. Running pipe

5/23 8" - 3295' T.D. 3355½'

Bail 1½ bbl. per hour.

P.B. to 3339' Shot 30 qts.

3323-30' C.O.

5/29 " " "

6/5 Chat. 3292'

8" - 3295'

T.D. 3359½'

Shot 30 qts. 3323-30'

P.B. to 3339'

Potential 135 bbls., pump.

COMPLETED

Map No. 48 Sec. 25 Twp. 20 R. 6WWell No. 4 HodgeW. C. McBride Company

Contractor

FIRST REPORT

C $N\frac{1}{2}$ SE NE Ft. from N. Line990 Ft. from S. Line660 Ft. from E. Line Ft. from W. Line

SECTION PLAT

BORNHOLDT POOL

Location Rig up

Drilling and Remarks:

Rigging up

Rotary

RECORD

Cased in., ft.Sand Gas Oil Total Depth

PRODUCTION

1st 24 hrs. Nat. 1st 24 hrs. after shot Gas Cu. Ft.Dry Hole Abandoned

Date

MAY 1 1940 19S. J. LEWIS Scout

Map No. 48 Sec. 25 Twp. 20 R. 6WWell No. 4 Hodge

W. C. McBride

Company

Contractor

COMPLETED

C $N\frac{1}{2}$ SE NE

Ft. from N. Line

990 Ft. from S. Line660 Ft. from E. Line

Ft. from W. Line

BORNHOLDT POOL

SECTION PLAT

			o

Location

Rig up

Drilling and Remarks:

*Chas 3292**8" 3295**309 to 3323-30**P. 3339**Pump 135 P.S.*

RECORD

Cased _____ in., _____ ft.

Sand _____

Gas _____

Oil _____

Total Depth 3357½

PRODUCTION

1st 24 hrs. Nat. _____

1st 24 hrs. after shot _____

Gas _____ Cu. Ft.

Dry Hole _____

Abandoned _____

Date

JUN 5 1940 19S. J. LEWIS Scout