

**KANSAS**


Rice

Form 51-5M-7-39-Palace

Section 25 Township 20 Range 6-W

Well No. #2 Hodges

Company Westgate Greenland

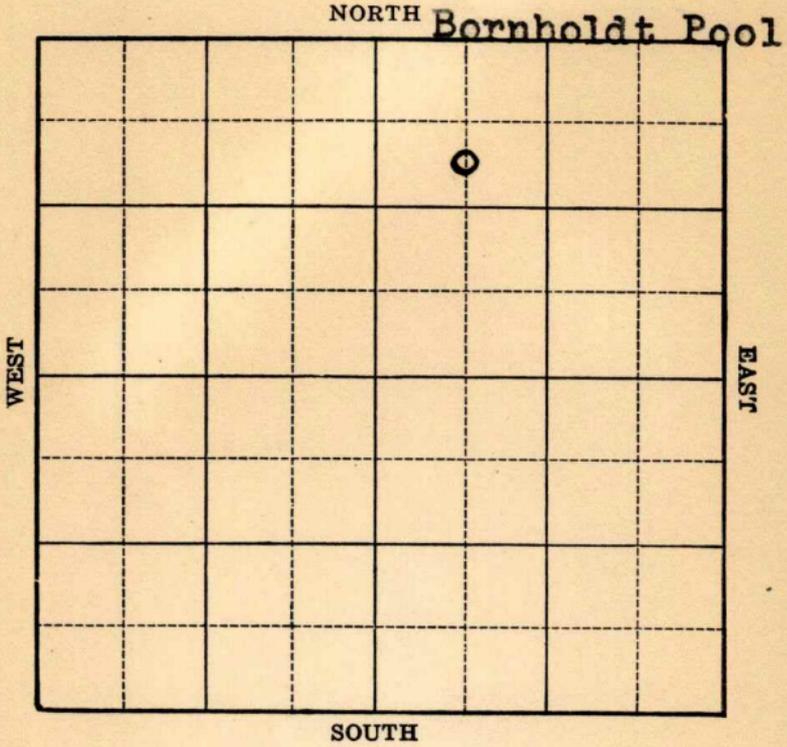

Sec. 25 Twp. 20 R. 6-W

Well No. #2 Hodges Farm

Westgate Greenland

Company


(Bornholdt)

990 Ft. from N. Line

\_\_\_\_\_ Ft. from S. Line

\_\_\_\_\_ Ft. from E. Line

660 Ft. from W. Line

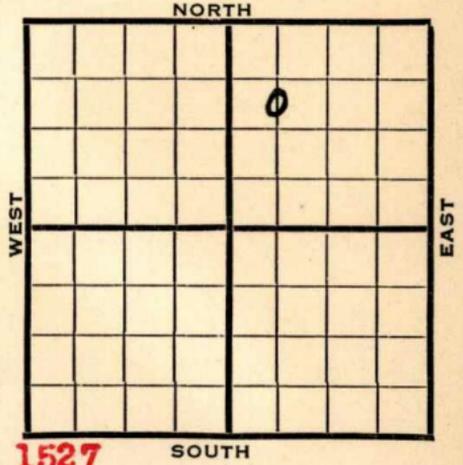

Elev. 1527

1940	REPORT
6/5	10" - 150'
	Drlg. 2940'
6/6	" "
6/13	Chat. 3289-90' T.D. 7" - 3290'
	RUST.
6/20	T.D. 3346' 250' oil.
	Shot 70 qts. 3296-3343' C.O.
6/26	Chat. 3289'
	7" - 3290'
	T.D. 3346'
	Shot 70 qts. 3296-3343'
	Pump 200 bbls.
	<b>COMPLETED</b>

Map No. 48 Sec. 25 Twp. 20 R. 6W

Well No. 2 Hodges

Westgate Greenland Company

Contractor

FIRST REPORT

C S L NW NE

SECTION PLAT

		o	

990 Ft. from N. Line

\_\_\_\_\_ Ft. from S. Line

\_\_\_\_\_ Ft. from E. Line

660 Ft. from W. Line

BORNHOLDT POOL

Location \_\_\_\_\_

Rig up \_\_\_\_\_

Drilling and Remarks:

10" - 150

Drlg. 2940

RECORD

Cased \_\_\_\_\_ in., \_\_\_\_\_ ft.

Sand \_\_\_\_\_

Gas \_\_\_\_\_

Oil \_\_\_\_\_

Total Depth \_\_\_\_\_

PRODUCTION

1st 24 hrs. Nat. \_\_\_\_\_

1st 24 hrs. after shot \_\_\_\_\_

Gas \_\_\_\_\_ Cu. Ft.

Dry Hole \_\_\_\_\_

Abandoned \_\_\_\_\_

Date

JUN 5 1940 19

S. J. LEWIS Scout

Map No. 48 Sec. 25 Twp. 20 R. 6W

Well No. 2 Hodges

Westgate Greenland Company

Contractor

**COMPLETED**

**SECTION PLAT**

C S L NW NE

990 Ft. from N. Line

\_\_\_\_\_ Ft. from S. Line

\_\_\_\_\_ Ft. from E. Line

660 Ft. from W. Line

BORNHOLDT POOL

		o	

Location \_\_\_\_\_

Rig up \_\_\_\_\_

Drilling and Remarks:

*Chat 3289*

*7" @ 3290*

*Shot 70 gals 3296 - 3343*

*Pump 200*

**RECORD**

Cased \_\_\_\_\_ in., \_\_\_\_\_ ft.

Sand \_\_\_\_\_

Gas \_\_\_\_\_

Oil \_\_\_\_\_

Total Depth 3346

**PRODUCTION**

1st 24 hrs. Nat. \_\_\_\_\_

1st 24 hrs. after shot \_\_\_\_\_

Gas \_\_\_\_\_ Cu. Ft.

Dry Hole \_\_\_\_\_

Abandoned \_\_\_\_\_

Date

JUN 26 1940

S. J. LEWIS Scout