


Section 25 Township 20 Range 6 W

Well No. # 1 Malm "B"

Company Sterling Drlg. et al

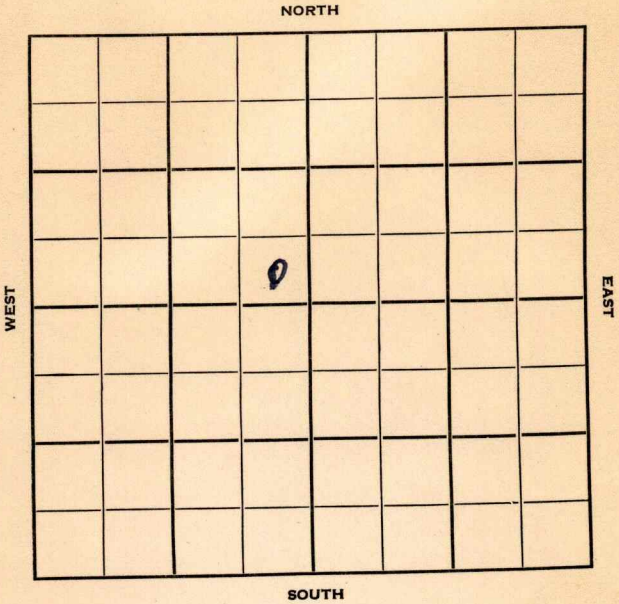

Rice

KANSAS

Sec. 25 Twp. 20 R. 6W

Well No. #1 Malm "B" Farm

Sterling Drlg. et al Company

Sterling Contractor


 Ft. from N. Line

330 Ft. from S. Line

330 Ft. from E. Line

 Ft. from W. Line

SE SE NW

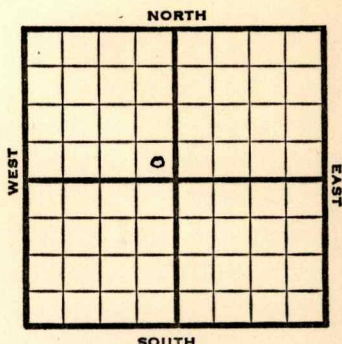

1952 Elev. 1523' REPORT

9/4 Spud 8-27-52
8" @ 120'
Drlg. 2758'

9/10 Cong 3242 Miss 3275 RTD 3305
5" @ 3305 DD 3336

9/17 TD 3336' PB 3330 150' oil in hole.
Hydra.

9/24 POP

10/1 P. 6/B0 & SOM wtr.

10/8 "

10/15 "

10/22 NR

10/29 Spud 8-27-52
D&A
TD 3336'
8" @ 120'
Cong. 3242', Miss 3275'
TD 3305'
5" @ 3305
DD 3336, PB 3330
FU 150' oil Hydro. P/6 bopd
D&A

ABANDONED

J. G. McGEHEE