


Section 25 Township 20 Range 6W

Well No. #3 Matt

Company Kewanee Oil

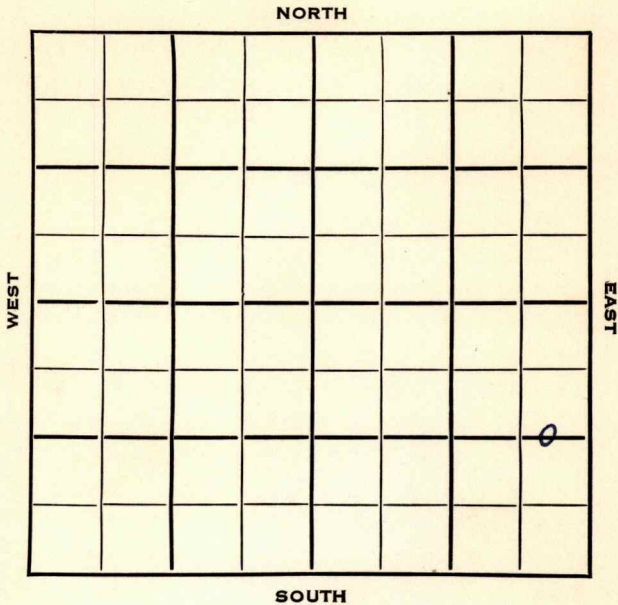

Rice KANSAS

SEC.	TWP.	R.
25	20	6W ✓

WELL NO.

3 Matt

FARM

COMPANY

Kewanee Oil

CONTRACTOR

Lewis Drlg.

elch-Barnholt Pool

1320

Ft. from N. Line


Ft. from S. Line

330

Ft. from E. Line

Ft. from W. Line

C E/2 E/2 SE

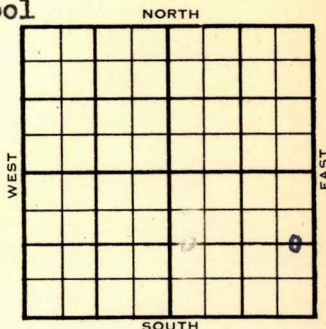

1954

ELEVATION

1522'

REPORT

3/17

MIR

3/24

8" @ 182' w/110 s sk
Drlg. 2 430'

3/31

KC 2722', Cong 3245', Miss 3267'

RTD 3290'

5" @ 3280'

C.O.

4/7

Spud 3-17-54

Oil Well

TD 3310'

8" @ 182'

KC 2722', Cong 3245', Miss 3267'

TD 3290'

5" @ 3280'

DD 3310' 7 go 1 gwph sd-oil-frac

Comp 51 bopd 68 bw.

COMPLETED

County **Rice** State **Kansas**

Sec. 25 (Blk.) 20 (Sur.) 6W Map No.

Operator **Kewanee Oil**

Well No. **3** Farm **Matt**

Elev.	Location	C	E $\frac{1}{2}$	E $\frac{1}{2}$	SE

FIRST REPORT

1320 Ft. From N Line SE

330 Ft. From **E** Line Quarter

1st. Report **MAR 17 1954**

Completion

Remarks

Lewis Drlg. - Contr.

Spudding Date _____

Drlg. Data Welch-Barnholt Pool

MIR


J. G. McGEHEE

County Rice State Kansas
 Sec. 25 (Blk.) 20 (Sur.) 6W Map No.

Operator Kewanee Oil

Well No. 3 Farm Matt

Elev. 1522 Location C E $\frac{1}{2}$ E $\frac{1}{2}$ SE

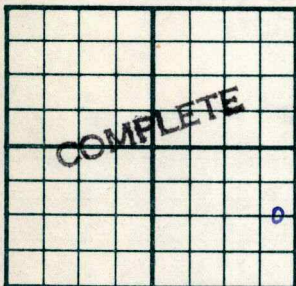

1320 Ft. From N Line SE

330 Ft. From E Line Quarter

1st. Report

APR 7 1954

Completion

Remarks Welch-Bornholt Pool

Lewis Drlg. - Contr.

Spudding Date 3-17-54

Drlg. Data Oil well TD 3310

8" @ 182 KC 2722 Cong. 3245

Miss. 3267 TD 3290 5" @ 3280

DD 3310 7 go 1 gwph sd-oil-frac

Comp. 51 bopd 68 bw