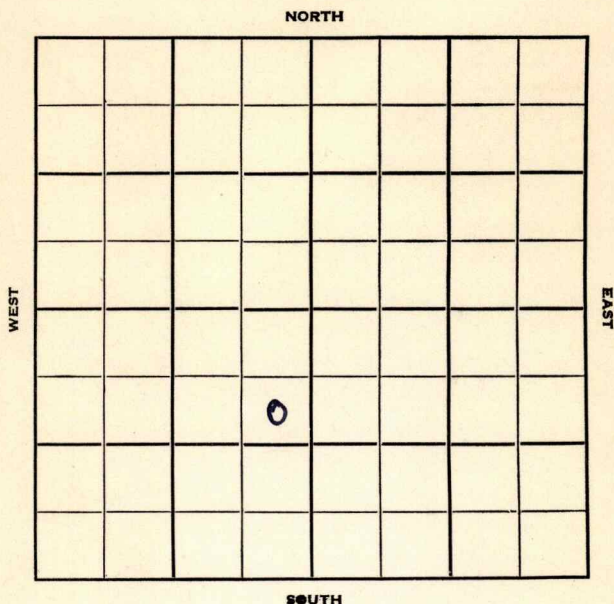


Section 25 Township 20 Range 6 WWell No. # 3 MalmCompany Kewanee Oil Co.

Rice

KANSAS

Sec. 25 Twp. 20 R. 6W

Well No. #3 Malm Farm

Kewanee Oil Co. Company

Goss Contractor


990 Ft. from N. Line

Ft. from S. Line

330 Ft. from E. Line

Ft. from W. Line

SE NE SW

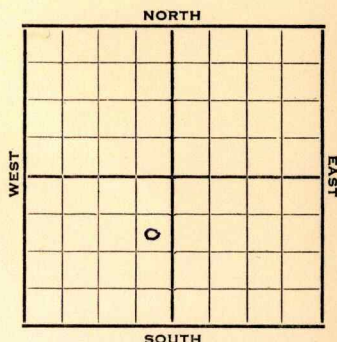

1952

Elev. 1523' REPORT

6/25

Location

7/2

8" @ 180
Drlg. 2355'

7/9

Br li 2689' KC 2709' Miss 3287'
RTD 3298' 5" @ 3287'

7/17

(5" @ 3297' Corrected)
DD 3307' TD Fill up 1800' oil 2 hrs.
S/154 BO 11 hrs. POP

7/23

NR

7/30

S/ 13 Boph 800' off btm.

8/6

Spud 6-25-52
Oil well TD 3307' 8" @ 180
Br. lime 2689' KC 2709' Miss 3287'
TD 3298' 5" @ 3297 DD 3307'
FU 1800' oil 2 hr. S/154 BO 11 hr.
S/13 BOPH
Comp. 100 BOPD

COMPLETED

County Rice State KansasSec. 25 (Blk.) 20 (Sur.) 6W Map No. (Twp.)Operator Kewanee Oil Co.Well No. 3 Farm MalmElev. Location SE NE SW

FIRST REPORT

0

990 Ft. From N Line SW330 Ft. From E Line Quarter1st. Report JUN 25 1952

Completion

Remarks

Goss - Contr.

Spudding Date

Drlg. Data

Location

J. G. McGEHEE

County Rice State Kansas

Sec. 25 (Blk. Twp.) 20 (Sur. Rge.) 6W Map No.

Operator Kewanee Oil

Well No. 3 Farm Malm

Elev.	1523	Location	SE NE SW
-------	------	----------	----------

990 Ft. From N Line SW

330 Ft. From E Line Quarter

1st. Report

Completion AUG 6 1952

Remarks

Gross Drlg. - Contr.

Spudding Date 6-25-52

Drilg. Data Oil well TD 3307

8" @ 180 Br. lime 2689 KC 2709

Miss. 3287 TD 3298 5" @ 3297

DD 3307 FU 1800' oil 2 hr. S/ 154 bo

11 hr. S/ 13 boph Comp. 100 bopd