


Section 25 Township 20 Range 6W

Well No. #2 Matt

Company Kewanee Oil

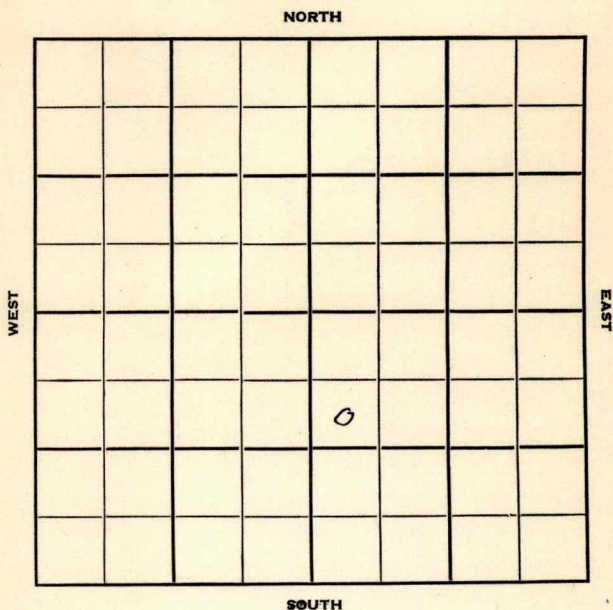

Rice **KANSAS**

Sec. 25 Twp. 20 R. 6W

Well No. #2 Matt Farm

Kewanee Oil Company

Contractor


990' Ft. from N. Line

Ft. from S. Line

Ft. from E. Line

330' Ft. from W. Line

SW NW SE

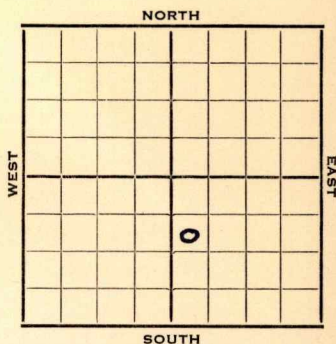

1952 **Elev. 1522'** REPORT

6/11 Spud 5-28-52
8" @ 177
Br Lime 2695 **Lans. 2716**
Miss 3276
TD 3311
5" @ 3278

6/18 CO 3311 B/17 galoph DD 3315
B/22 galoph DD 3320 $\frac{1}{2}$ TD
S $\frac{1}{2}$ BOPH for 3 hrs Hyd.

6/25 2 $\frac{1}{2}$ Bo & 1 $\frac{1}{4}$ Bwph POP

7/2 NR

7/9 Spud 5-28-52
Oil Well TD 3320
8" @ 177
Br Lime 2695 **Lans. 2718**
Miss 3276 TD 3311 5" @ 3278
CO to 3311 B/17 goph DD 3315
B/22 goph DD 3320 S $\frac{1}{2}$ boph
Hydro S/2 $\frac{1}{2}$ bo 1 $\frac{1}{4}$ bwph
Comp. 40 bopd 5% wtr.

COMPLETED

County **Rice** State **Kansas**

Sec. 25 (Blk.) 20 (Sur.) 6W Map No.

Operator **Kewanee Oil**

Well No. 2 Farm Matt

Elev.	1522	Location	SW NW SE
-------	------	----------	----------

0

990 Ft. From N Line SE

330 Ft. From W Line Quarter

1st. Report JUN 11 1952

Completion

Remarks

Spudding Date 5-28-52

Drlg. Data

8" @ 177 Br. lime 2695 Lams. 2718

Miss. 3276 TD 3311 5" @ 3278

J. G. McGEHEE

County Rice State Kansas
 Sec. 25 (Blk.
Twp.) 20 (Sur.
Rge.) 6W Map No.

Operator Kewanee Oil

Well No. 2 Farm Matt

Elev. 1522 Location SW NW SE



990 Ft. From N Line SE

330 Ft. From W Line Quarter

1st. Report

Completion JUL 9 1952

Remarks

Spudding Date 5-28-52

Drlg. Data Oil well TD 3320

8" @ 177 Br. lime 2695 Lans. 2718

Miss. 3276 TD 3311 5" @ 3278

CO to 3311 B/ 17 goph DD 3315

B/ 22 goph DD 3320 S/ $\frac{1}{2}$ boph

Hydro. S/ $2\frac{1}{2}$ bo $1\frac{1}{4}$ bwph

Comp. 40 bopd 5% water

J. G. McGEHEE