


Section 25 Township 20 Range 7W

Well No. #1 Leonard

Company Hinkle Oil

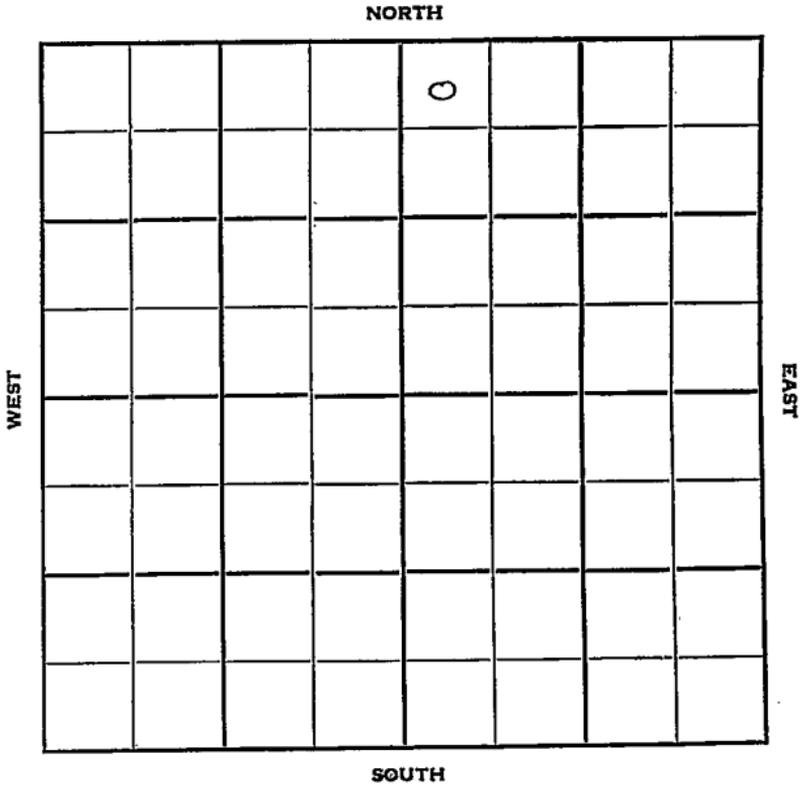

Rice

KANSAS

Sec. 25 Twp. 20 R. 7 W

Well No. # 1 Leonard Farm

Hinkle Oil Company

Wildcat Contractor


330 Ft. from N. Line

_____ Ft. from S. Line

_____ Ft. from E. Line

330 Ft. from W. Line

NW NW NE
Magnolia Farmout

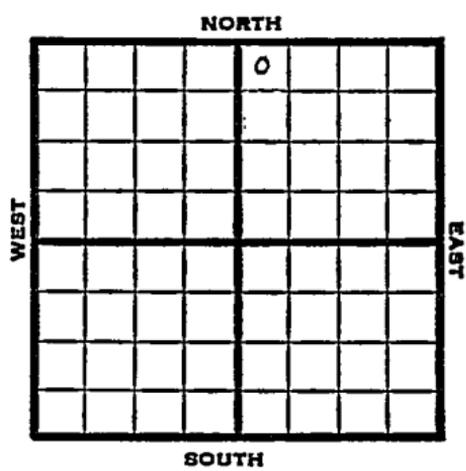

1951 Elev. 1657' REPORT

9/26 Spud 9-21-51
8" @ 95
Drlg. 340'

10/3 Spud 9-21-51
D & A TD 3410'
8" @ 95 Heeb 2699' Br. lime 2863'
Lans. 2889' Cong. 3367' Miss 3377'
DST 3370-3410' open 43 min. rec 25' mud
D & A

ABANDONED

County Rice State Kansas

Sec. 25 (Blk. Twp.) 20 (Sur. Rge.) 7W Map No.

Operator Hinkle Oil

Well No. 1 Farm Leonard

Elev. Location NW NW NE

330 Ft. From N Line NE

330 Ft. From W Line Quarter

Ist. Report SEP 26 1951

Completion

Remarks Magnolia farmout

Spudding Date 9-21-51

Drlg. Data Wildcat

8" @ 95 drlg. 340

J. E. TYRA

County Rice State Kansas

Sec. 25 (Blk. Twp.) 20 (Sur. Rge.) 7W Map No.

Operator Hinkle Oil

Well No. 1 Farm Leonard

Elev. 1657 Location NW NW NE

			0		

ABANDONED

330 Ft. From N Line NE

330 Ft. From W Line Quarter

1st. Report

Completion OCT 3 1951

Remarks Wildcat

Spudding Date 9-21-51

Drilg. Data D & A TD 3410

8" @ 95 Heeb. 2699 Br. lime 2863

Lans. 2889 Cong. 3367 Miss. 3377

DST 3370-3410 open 43 min. Rec. 25' mud
D & A