

KANSAS Rice

Section 26 Township 20 Range 6W

Well No. 1 Hubnett

Company Petroleum Inc.

Welch Pool

NORTH

WEST	0							

EAST

SOUTH

HOT FILE

KANSAS

Rice

6-W



Sec. 26 Twp. 20 R. 6-W

Well No. #1 Hubnett Farm

Petroleum Inc.

Company

Welch


330 Ft. from N. Line

Ft. from S. Line

Ft. from E. Line

330 Ft. from W. Line

NW/C

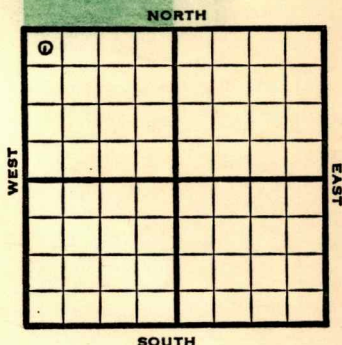

1948 **Elev. 1590'** REPORT

12/22 8" @ 135
Drlg 1540'

12/29 **Miss 3333'**
DST 3333-40 open 1 hr 20' mud
Drlg. 3342'

1949
1/5 **Miss 3333'**
Kind 3394'
TD 3410'

ABANDONED

Kansas

Welch Pool

Map No. _____ Sec. 26 Twp. 20 R. 6WWell No. 1 Hubnett

Petroleum Inc.


Company

FIRST REPORT

Contractor

NW/C

SECTION PLAT

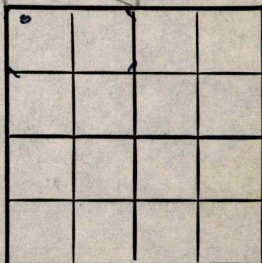330 Ft. from N. Line

_____ Ft. from S. Line

_____ Ft. from E. Line

330 Ft. from W. Line

Rice County

RECORD

Location _____

Cased _____ in., _____ ft.

Rig up _____

Sand _____

Drilling and Remarks:

Gas _____

Oil _____

Total Depth _____

8" @ 135

PRODUCTION

drlg. 1540

1st 24 hrs. Nat. _____

1st 24 hrs. after shot _____

Gas _____ Cu. Ft.

Dry Hole _____

Abandoned _____

Date

DEC 22 1948

19

S. J. LEWIS

Scout

Kansas

Map No. 48 Sec. 26 Twp. 20 R. 6WWell No. 1 Hubenett

Petroleum Inc.

Company

ABANDONED

Contractor

NW/C

B.I. 1590

SECTION PLAT

330


Ft. from N. Line

Ft. from S. Line

Ft. from E. Line

330

Ft. from W. Line

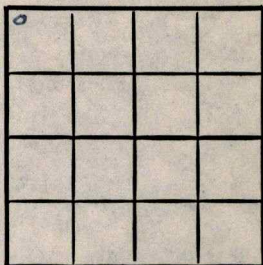

Rice County

Location

Rig up

Drilling and Remarks:

Nov 8883
Nov 8894

RECORD

Cased _____ in., _____ ft.

Sand _____

Gas _____

Oil _____

Total Depth 3410

PRODUCTION

1st 24 hrs. Nat. _____

1st 24 hrs. after shot _____

Gas _____ Cu. Ft.

Dry Hole _____

Abandoned _____

Date

JAN 5 1949 19

S. J. LEWIS

Scout