


Rice

KANSAS

Section 26 Township 20 Range 6W

Well No. #1 Johnson "B"

Company Sterling Drlg.

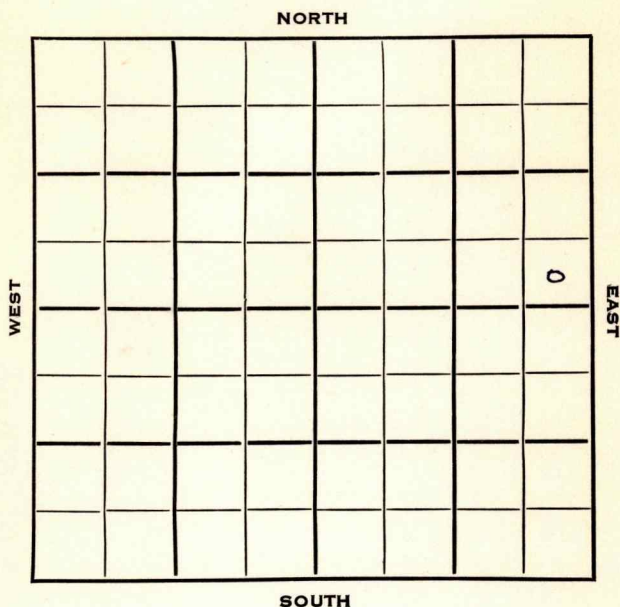

Rice

KANSAS

Sec. 26 Twp. 20 R. 6 WWell No. # 1 Johnson "B" Farm

Sterling Drlg.

Company

Sterling Drlg.

Contractor

Ft. from N. Line

330


Ft. from S. Line

330

Ft. from E. Line

Ft. from W. Line

SE SE NE

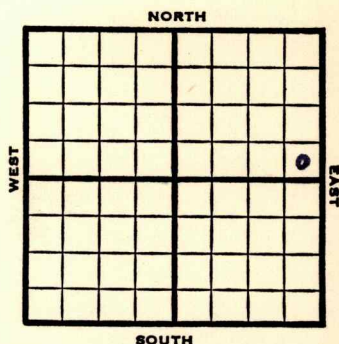

1953 Elev. 1539' REPORT

2/11 RUR

2/19 8" @ 130
Drlg. 2985'2/26 Miss 3297
RTD 3304

3/12 Testing

3/19 "

3/25 Spud 2-10-53

Oil Well

TD 3321

8" @ 130

Miss 3297

TD 3304

5" @ 3304

TD 3319


DD 3321, S/6 boph A-frac

S/ 15 boph

Comp. 50 bopd

COMPLETED

County Rice State Kansas
 Sec. 26 (Blk.) 20 (Sur.) 6W Map No.
 Operator Sterling Drlg.
 Well No. 1 Farm Johnson "B"
 Elev. _____ Location SE SE NE

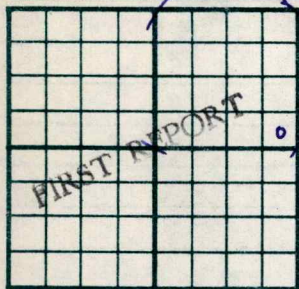

330 Ft. From S Line NE

330 Ft. From E Line Quarter

1st. Report FEB 11 1953

Completion _____

Remarks _____

Sterling Drlg. - Contr.


Spudding Date _____

Drlg. Data _____

R U R

J. G. McGEHEE

County Rice State Kansas
 Sec. 26 (Blk.) 20 (Sur.) 6W Map No. _____
 Operator Sterling Drlg. & NCRA
 Well No. 1 Farm Johnson "B"
 Elev. 1539 Location SE SE NE

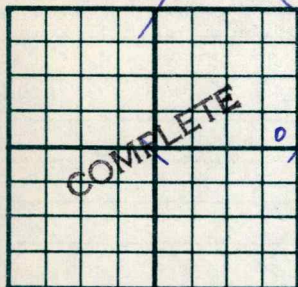

330 Ft. From S Line NE
330 Ft. From E Line Quarter

1st. Report

Completion MAR 25 1953

Remarks

Sterling Drlg. - Contr.

Spudding Date 2-10-53

Drlg. Data Oil well TD 3321
8" @ 130 Miss. 3297 TD 3304
5" @ 3304 TD 3319 DD 3321 S/ 6 boph
A-frac S/ 15 boph Comp. 50 bopd

J. G. McGEHEE