

26

20

6 W

Section _____ Township _____ Range _____

Well No. #1 Lindholm

Company Petroleum Inc.

NORTH

			0						

SOUTH

Rice

KANSAS


SEC. 26	TWP. 20	R. 6 W	✓
------------	------------	-----------	---

WELL NO. # 1 Lindholm FARM

COMPANY Petroleum Inc.

CONTRACTOR Garvey
Welch-Bornholdt Pool

330 _____ Ft. from N. Line
 _____ Ft. from S. Line
 330 _____ Ft. from E. Line
 _____ Ft. from W. Line

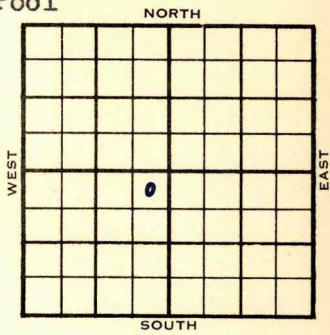

NE NE SW

	ELEVATION	REPORT
1953	1592'	
10/28	Spud 10-22-53 8" @ 219 Drlg. 2675'	
11/4	Spud 10-22-53 D & A TD 3424' 8" @ 219'	
	Lans 2792', Cong 3348', Miss 3350'	
	DST 3350'-65' opn 1 hr, rec 45' vsocm Off.	
	DST 3365'-75' opn 3/4 hr, rec 32' mud Off.	
	Kh. 3418'	
	TD 3424'	
	D & A	

ABANDONED

County Rice State Kansas

Sec. 26 (Blk. Twp.) 20 (Sur. Rge.) 6W Map No.

Operator Petroleum Inc.

Well No. 1 Farm Lindholm

Elev. _____ Location NE NE SW

FIRST REPORT					

330 Ft. From N Line SW

330 Ft. From E Line Quarter

1st. Report OCT 28 1953

Completion _____

Remarks _____

Garvey - Contr.

Spudding Date 10-22-53

Drlg. Data Welch-Bornholdt Pool

8" @ 219 drlg. 2675

