


Section 26 Township 20 Range 6W

Well No. #1 2 Slabach

Company Stag Drlg. et al

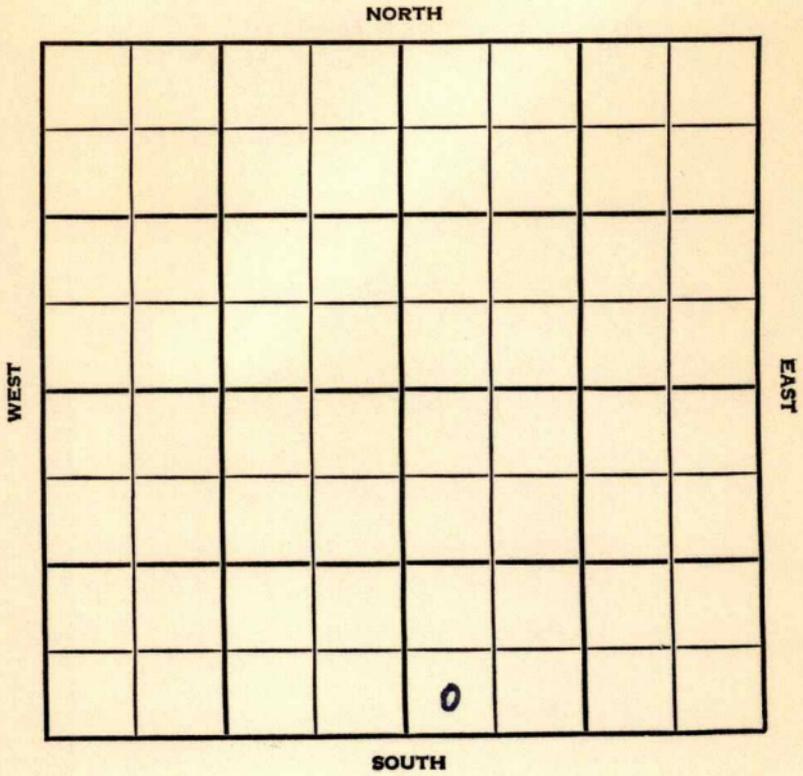







# SCOUT TICKET

DX-201

~~Kansas~~

SEC.

TWP.

R.

26

20

6W

WELL NO.

1 Slabach

FARM

COMPANY

Stag Drlg. etal.

CONTRACTOR

CORRECTION


SW SW SE

\_\_\_\_\_ FT. FROM N. LINE

330 \_\_\_\_\_ FT. FROM S. LINE

\_\_\_\_\_ FT. FORM E. LINE

330 \_\_\_\_\_ FT. FROM W. LINE

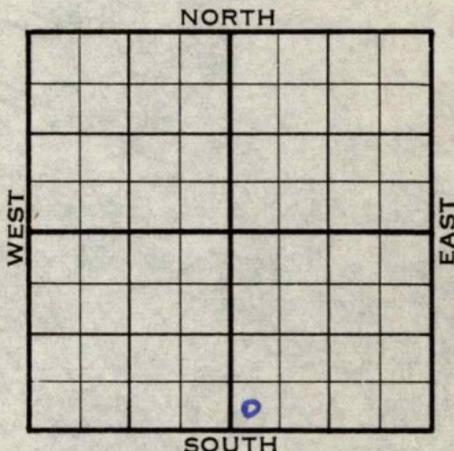

Rice County

LOCATION *SLAB*

RIG UP

DRILLING AND REMARKS:

Reported  
#2 Slabach

<b>RECORD</b>	CASED _____ IN., _____ FT.
	SAND _____
	GAS _____
	OIL _____
<b>PRODUCTION</b>	TOTAL DEPTH _____
	1ST 24 HRS. NAT. _____
	1ST 24 HRS. AFTER SHOT _____
	GAS _____ CU. FT.
	ABANDONED _____

DATE  
FEB 23 1955

SCOUT

FABEN GIL STRAP