


Rice

FORM 51

Section 26 Township 20 Range 6W **KANSAS**

Well No. #1 Laura Slaback

Company Jess Cling.

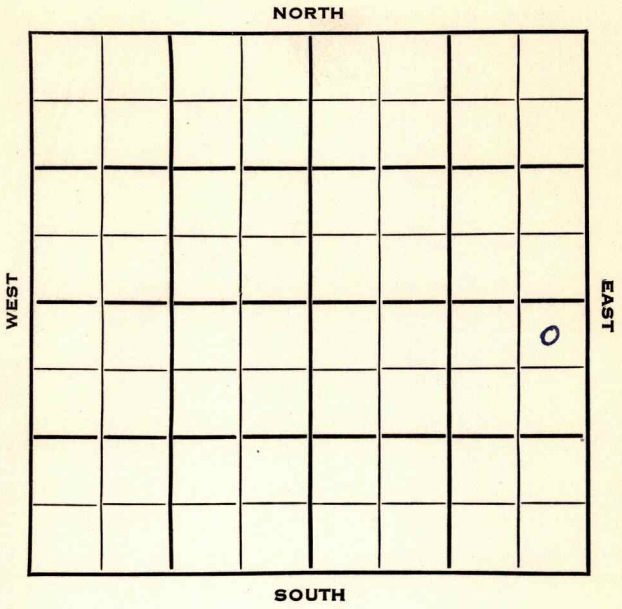

SEC.	TWP.	R.
26	20	6W ✓

WELL NO.

1 Laura Slaback

FARM

COMPANY

Jess Cling

CONTRACTOR

Slusser Drlg.

Welch-Barnholt Pool


330 Ft. from N. Line

Ft. from S. Line

330 Ft. from E. Line

Ft. from W. Line

NE NE SE

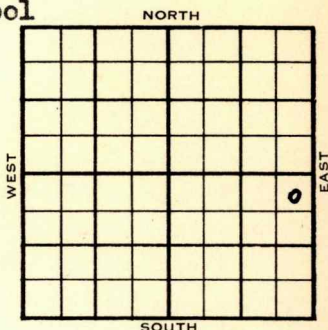

1954

ELEVATION

1545'

REPORT

3/17

RUR

3/24

8" @ 128' w/100 sks
Drlg. 2260'

3/31

Miss 3317'

RTD 3321'

5" @ 3320'

4/7

WOCT

5/12

Spud 3-17-54

D&A

TD 3362'

8" @ 128'

Miss 3317'

TD 3321'

5" @ 3320'

DD 3362'

Hydro.

P/5 bopd 60%

D&A

ABANDONED

County Rice State KansasSec. 26 (Blk.) 20 (Sur.) 6W Map No.Operator Jess ClingWell No. 1 Farm Laura SlabackElev. Location NE NE SE

330 Ft. From N Line SE330 Ft. From E Line Quarter1st. Report MAR 17 1954

Completion

Remarks

Slusser Drlg. - Contr.

Spudding Date

Drlg. Data Welch-Barnholt PoolRUR

County Rice State KansasSec. 26 (Blk.
Twp.) 20 (Sur.
Rge.) 6W Map No.Operator Jess ClingWell No. 1 Farm Laura SlabackElev. 1545 Location NE NE SE330 Ft. From N Line SE330 Ft. From E Line Quarter

1st. Report

Completion MAY 12 1954Remarks Welch-Bornholdt PoolSlusser Drlg. - Contr.Spudding Date 3-17-54Drlg. Data D & A TD 33628" @ 128 Miss. 3317 TD 33215" @ 3320 DD 3362 Hydro. P/ 5 bopd 60%D & A

J. G. McGEHEE