

KANSAS

Rice


Section 26 Township 20 Range 6W

Well No. 1 Johannsen

Company Don Ingling

Wildcat

NORTH

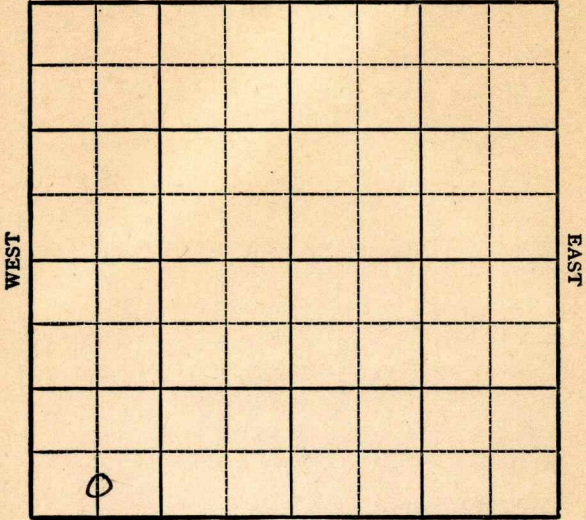

SOUTH

Rice

Sec. 26 **KANSAS** Twp. 20 R. 6W ✓

Well No. #1 Johnnsen Farm

Don Ingling Company

Wildcat


\_\_\_\_\_ Ft. from N. Line

330' Ft. from S. Line

\_\_\_\_\_ Ft. from E. Line

660' Ft. from W. Line

C S L SW SW

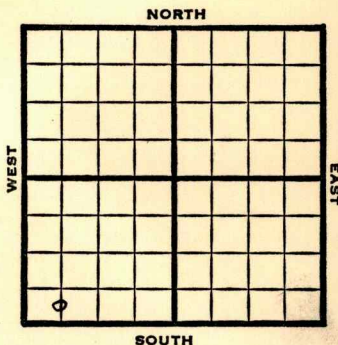

1948

**Eli 1594'**

REPORT

10/20

Location

10/26

8" @ 90'  
Drlg. 2350'

11/3

**Lansing 2802'**  
Drlg 3315'

11/10

TD 3419'  
**Miss 3354'**  
Aband.

**ABANDONED**

Kansas

Map No. \_\_\_\_\_ Sec. 26 Twp. 20 R. 6W

Well No. 1 Johannsen

Don Ingling Company

FIRST REPORT Contractor

C S L SW SW

SECTION PLAT


\_\_\_\_\_ Ft. from N. Line

330

\_\_\_\_\_ Ft. from S. Line

\_\_\_\_\_ Ft. from E. Line

660 \_\_\_\_\_ Ft. from W. Line

Rice County

RECORD

Location X

Cased \_\_\_\_\_ in., \_\_\_\_\_ ft.

Rig up \_\_\_\_\_

Sand \_\_\_\_\_

Drilling and Remarks:

Gas \_\_\_\_\_

Oil \_\_\_\_\_

Total Depth \_\_\_\_\_

PRODUCTION

1st 24 hrs. Nat. \_\_\_\_\_

1st 24 hrs. after shot \_\_\_\_\_

Gas \_\_\_\_\_ Cu. Ft.

Dry Hole \_\_\_\_\_

Abandoned \_\_\_\_\_

Date

OCT 20 1948

19

S. J. LEWIS

Scout

