


Section 27 Township 20 Range 8 W

Well No. # 2 W. Edgar

Company Tom Allen

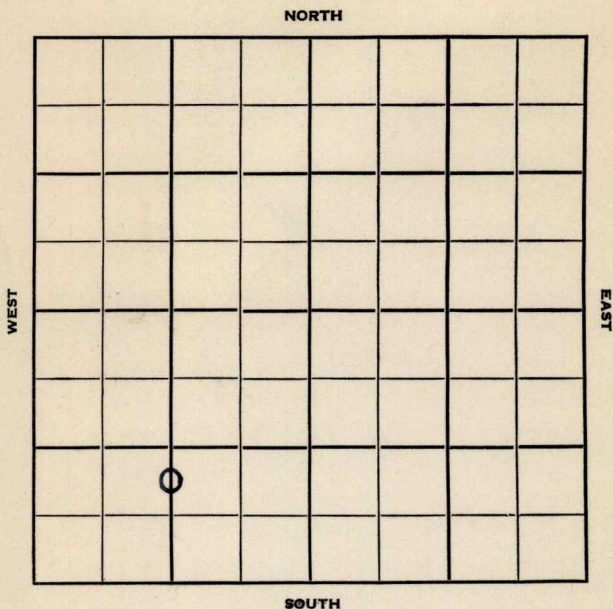

Rice

KANSAS

Sec. 27 Twp. 20 R. 8 W

Well No. # 2 W. Edgar Farm

Tom Allen Company

Tom Allen Contractor


Ft. from N. Line

990 Ft. from S. Line

Ft. from E. Line

1320 Ft. from W. Line

N/2 S/2 SW

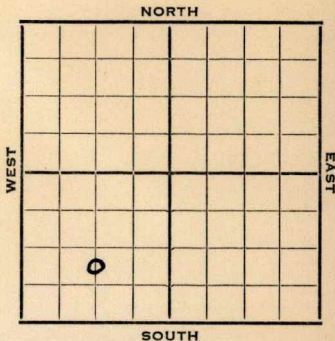

1952 Elev. 1659' REPORT

3/26
4/1
4/9
4/23

RUR
 8" @ 208'
 Drlg. 2633'
 5" set
 Spud 3-25-52
 Oil Well TD 3317
 8" @ 208
 Lans. 2897 Cong. 3296
 5" @ 3297 TD 3317
 Hydro S/ 3 boph
 Comp. 25 bopd

COMPLETED

County Rice State Kansas

Sec. 27 (Blk. Twp.) 20 (Sur. Rge.) SW Map No.

Operator Tom Allen

Well No. 2 Farm W. Edgar

Elev. Location N/2 S/2 SW

990 Ft. From S Line SW

1320 Ft. From W Line Quarter

1st. Report MAR 26 1952

Completion

Remarks

Tom Allen - Contr.

Spudding Date

FIRST REPORT

Drlg. Data

RUR

