

Map No. _____ Sec. 27 Twp. 20 R. 3-W

Well No. 3 - Stucky Farm


Slick, Bryon & Lockhart Company

_____ Ft. from N. Line

1320 Ft. from S. Line

_____ Ft. from E. Line

330 Ft. from W. Line

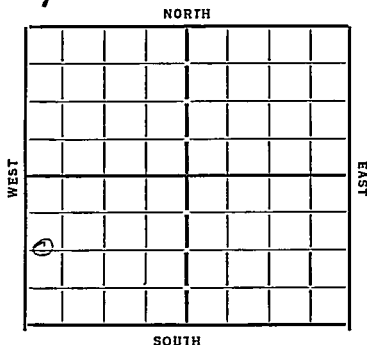

Date	REPORT
1933	
8/2	location
8/9	—
8/17	—
8/23	—
8/30	—
9/6	—
9/13	—
9/20	—
9/29	—
10/5	Mousing in
10/11	Bldg
10/18	12" at 176 - dreg 371
10/25	dreg 2056
11/1	7895
11/8	Top Chat 3011
	Top Viola 3324 - 5" at 3330
	Base Line 3105 P.M.S.T.
11/15	Milcov 3392 - T.D 3397
	300' oil in hole
11/22	Shot 40 gts 3395-3413
	Swab 32 gals per hr
11/29	Shot 100 gts - swab 400
	bbl in 13 hrs - run rods.
12/6	e.o


Map No. 43 Sec. 27 Twp. 20 R. 3W

Well No. 3 - Stucky

Slick, Pryor & Eckhart Company

Contractor

SECTION PLAT

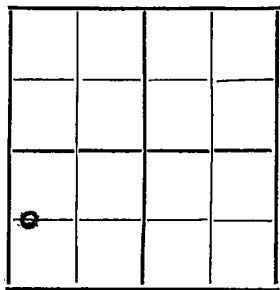

Ft. from N. Line

1320 Ft. from S. Line

Ft. from E. Line

330 Ft. from W. Line

FIRST REPORTS

Location.....

Rig up.....

Drilling and Remarks:

RECORD

Cased.....in.,ft.

Sand.....

Gas.....

Oil.....

Total Depth.....

PRODUCTION

1st 24 hrs. Nat.

1st 24 hrs. after shot.....

Gas.....Cu. Ft.

Dry Hole.....

Abandoned.....

Date

8/7/33 192 O. Mannick Scout

Form 267 M. Bks. - 9-26
J. J. Purson

Map No. 43 Sec. 27 Twp. 20 R. 3W

Well No. 3 - Stucky

Slick spray & Packhat Company

Contractor

COMPLETED

SECTION PLAT

..... Ft. from N. Line

1320 Ft. from S. Line

..... Ft. from E. Line

330 Ft. from W. Line

Location.....

Rig up.....

Drilling and Remarks:

583 bbls

RECORD

Cased 1 in., 3392 ft.

Sand Wilson

Gas.....

Oil.....

Total Depth 3419

PRODUCTION

1st 24 hrs. Nat.....

1st 24 hrs. after shot.....

Gas..... Cu. Ft.

Dry Hole.....

Abandoned.....

Date

12-27-33 V. Mansch Scout

1933

12/13 Pump 540 lbs 24 hrs

12/20 Wagon 3392 FD, 3419

883 lbs

COMPLETED