
Form 51—5M—1-30—38840

McPherson

Map No. _____ Sec. 27 Twp. 20 R. 3 W

Well No. 4 Stuckey Farm

Slick, Cryer & Lockhart Company

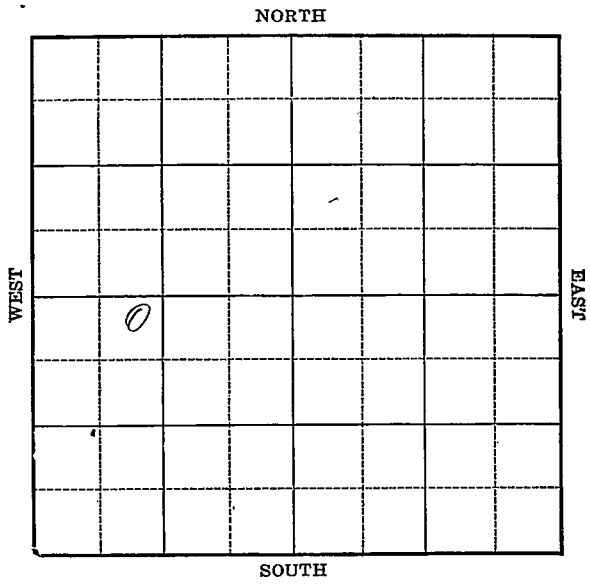

Location _____

Drilling Remarks

Rig Up _____

Drilling Remarks

RECORD

Cased _____ in. _____ ft.

Sand _____

Gas _____

Oil _____

Total Depth _____

PRODUCTION

1st 24 hrs. Nat. _____

1st 24 hrs. after shot _____

Gas _____ cu. ft. _____

Dry Hole _____

Abandoned _____


McPherson

Form 252-A
5M 4-32 MPC

Map No. KANSAS Sec. 27 Twp. 20 R. 3 E

Well No. 4 Stucky Farm

Slick Pryor & Lockhart Company

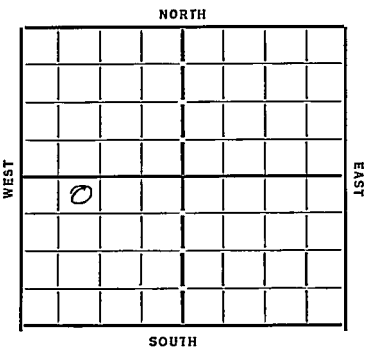

330' Ft. from N. Line

_____ Ft. from S. Line

_____ Ft. from E. Line

990 Ft. from W. Line

Date 1932	REPORT
12/6	Cellar
12/13	Rig up Rotary
12/27	Drlg 2584
1/4	Top Chat 3042
1/11	Viola 3399.
	7" at 3397 - RM ST.
1/17	Wilcox 3465 T.D. 3481
	Show oil & 300' water
1/24	Siliceous 3509 - T.D. 3512 Fish
1/31	—
2/7	—
2/14	Siliceous 3509 TD 3512 D & A
	ABANDONED

Form 26 1M Rec 9-26

Map No. 43 Sec. 27 Twp. 20 R. 3W

Well No. 4- Stucky

Slick, Bryon & Lockhart Company

Contractor

FIRST REPORTS


330 Ft. from N. Line

Ft. from S. Line

Ft. from E. Line

990 Ft. from W. Line

SECTION PLAT

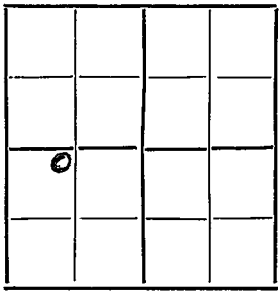

Location

Rig up

Drilling and Remarks:

cellar

RECORD

Cased in., ft.

Sand

Gas

Oil

Total Depth

PRODUCTION

1st 24 hrs. Nat.

1st 24 hrs. after shot

Gas Cu. Ft.

Dry Hole

Abandoned

Date

12-6-33 192

O. Mannicheck Scout

Form 26—1M-Bks-9-28

Map No. 43 Sec. 27 Twp. 20 R. 3W

Well No 4 - Stanley

Slick Cryor & Lockhart Company

Contractor

ABANDONED


330 Ft. from N. Line

Ft. from S. Line

Ft. from E. Line

990 Ft. from W. Line

SECTION PLAT

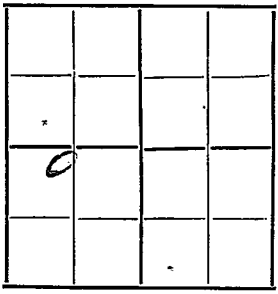

Location

Rig up

Drilling and Remarks:

10 + ff

RECORD

Cased ..... in., ... ft.

Sand Siliceous 3509

Gas

Oil

Total Depth 3512

PRODUCTION

1st 24 hrs. Nat.

1st 24 hrs. after shot

Gas ..... Cu. Ft.

Dry Hole

Abandoned

Date

7-14-34 192 O. Mannschreck Scout