

McPherson

Form 51-5M-11-31-Palace

Map No. KANSAS

Sec.

27

Twp.

20

R.

3^W

Well No.

2-

Stuckey

Farm

Stuckey-Bryce & Lockhart

Company

NORTH

WEST

EAST

SOUTH

Location

Drilling Remarks

Rig Up

Drilling Remarks

RECORD

Cased in. ft.

Sand

Gas

Oil

Total Depth

PRODUCTION

1st 24 hrs. Nat.

1st 24 hrs. after shot

Gas cu. ft.

Dry Hole


Abandoned

Map No. KANSAS Sec. 27 Twp. 20 R. 3^w

Well No. 2- Stuckey Farm

Leck-Preford Lockhart Company

NORTH

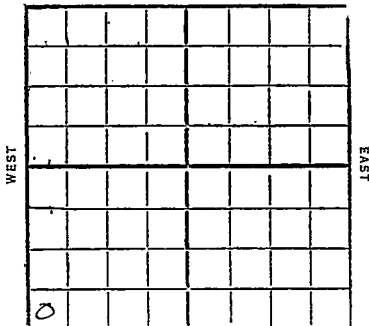

_____ Ft. from N. Line

330 Ft. from S. Line

_____ Ft. from E. Line

330 Ft. from W. Line

SOUTH

Date

REPORT

8/31	Pos.
9/7	
9/14	Bldg rig
9/21	Spdg 50'
9/30	12 1/2" - 162
	Dreg 1640'
10/5	Top Chat 3012
	dreg 3072'
10/12	Bake line 3117
	Top Viola 3351
	Cem 8" - 3355'
10/19	Top Green shale 3409
	Milcox 3416
	T.D. 3433 1/2
	swab 30 bbl oil
10/26	T.D. 3433 1/2'
	Setting engine
11/2	T.D. 3433 1/2' Go swab
	No test
11/9	—
11/16	—

(over)

11/23- TD 3433½

shot 40 qt 3418-28

swab 453 bbl 10½ hr

11/30- TD 3433½

swab 45 bbl per hr

12/7- TD 3433½ Rng tubing

12/14- TD 3433½ pumping
No test

12/21- Kelco 3416-33½

TD 3433½

shot 40 qt 3418-28

Bump 827½ bbl 24 hr
Comp.

McPherson

43 KANSAS

Map No. Sec. 27 Twp. 20 R. 3 W

Well No. 2 Stuckey

Slick, Pryor & Lockhart Company

Contractor

FIRST REPORTS

Ft. from N. Line

320 Ft. from S. Line

Ft. from E. Line

330 Ft. from W. Line

SECTION PLAT

0			

Location

Rig up

Drilling and Remarks:

R. O. G.

RECORD

Cased in., ft.

Sand

Gas

Oil

Total Depth

PRODUCTION

1st 24 hrs. Nat.

1st 24 hrs. after shot

Gas Cu. Ft.

Dry Hole

Abandoned

Date

192

Scout

43 KANSAS

Map No. Sec. 27 Twp. 20 R. 3^W

Well No. 2 Stuckey

Slicks, Payer & Lockhart Company

Contractor

COMPLETED


Ft. from N. Line

330 Ft. from S. Line

Ft. from E. Line

330 Ft. from W. Line

SECTION PLAT

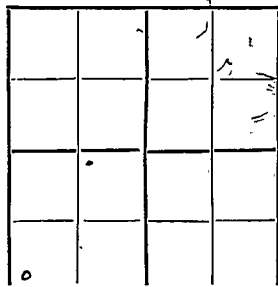

Location

Rig up

Drilling and Remarks:

Shot 40/3418-28

Pump 827 1/2 Bbl
24 Hrs.

RECORD

Cased in, ft.

Sand 3416-33 1/2

Gas

Oil

Total Depth 3433 1/2

PRODUCTION

1st 24 hrs. Nat.

1st 24 hrs. after shot

Gas Cu. Ft.

Dry Hole

Abandoned

Date

DEC 2 1 1932

CHAS. L. SHERWOOD

192

Scout