McPherson

KANSAS


FORM 51 10M 12-46 PETROL

Section 27 Township 20 Range 3-W

Well No. #6 Stucky

Company Aylward Prod

Voshell Pool

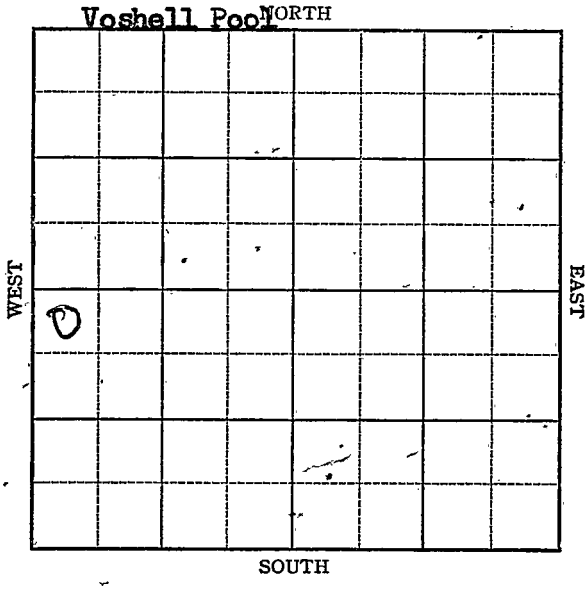

FORM 252-A
5M 12-46 PETROL

KANSAS — McPherson County

Sec. 27 Twp. 20 R. 3-W

Well No. 6 Stucky Farm

Aylward Prod. Company

Voshell Pool


330 Ft. from N. Line

_____ Ft. from S. Line

_____ Ft. from E. Line

330 Ft. from W. Line

NW SW

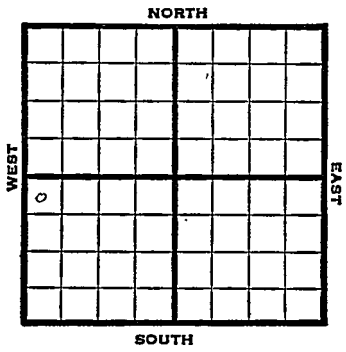

1947	Elev. 1476' REPORT
8/20	Loc.
8/27	8" @ 250' Drlg. 2011'
9/3	Viola 3360 Simp. 3370 Arbuckle 3464-67 TD Run 5"
9/10	5" @ 3465' 2500' water
9/17	TD 3494' 3000' W PB
9/24	Arb. 3464' 5" @ 3465' TD 3467'

ABANDONED

Form 26 200 Bks. 10-46 Petrol

Kansas

Voshell Pool

Map No. _____ Sec. 27 Twp. 20 R. 3W

Well No. 6 Stucky

Aylward Prod. Company

FIRST REPORT Contractor

NW SW

330 Ft. from N. Line


_____ Ft. from S. Line

_____ Ft. from E. Line

330 Ft. from W. Line

McPherson County

SECTION PLAT

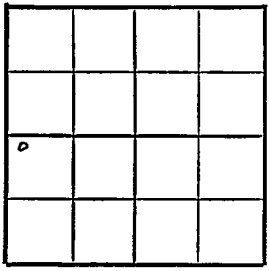

Location x

Rig up _____

Drilling and Remarks:

RECORD

Cased _____ in., _____ ft.

Sand _____

Gas _____

Oil _____

Total Depth _____

PRODUCTION

1st 24 hrs. Nat. _____

1st 24 hrs. after shot _____

Gas _____ Cu. Ft.

Dry Hole _____

Abandoned _____

Date

AUG 20 1947 19 _____

S. J. LEWIS Scout

Form 26 200 Bks. 10-46 Petrol

Kansas

Voshell Pool

Map No. 43 Sec. 27 Twp. 20 R. 3W

Well No. 6 Stucky


Aylward Prod. Company

ABANDONED Contractor

NW SW

El. 1476

SECTION PLAT

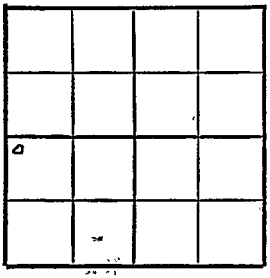

330 Ft. from N. Line

Ft. from S. Line

Ft. from E. Line

330 Ft. from W. Line

McPherson County

Location

Rig up

Drilling and Remarks:

OH 3464

5" @ 3465'

RECORD

Cased in., ft.

Sand

Gas

Oil

Total Depth 3467'

PRODUCTION

1st 24 hrs. Nat.

1st 24 hrs. after shot

Gas Cu. Ft.

Dry Hole

Abandoned

Date

SEP 2 4 1947 19

S. J. LEWIS Scout