


Rice

FORM 51 25M 3-49 PETROL

Section 27 Township 20 Range 6W
Well No. #1 Wernett (Wernet)
Company Inland Oil et al

NORTH

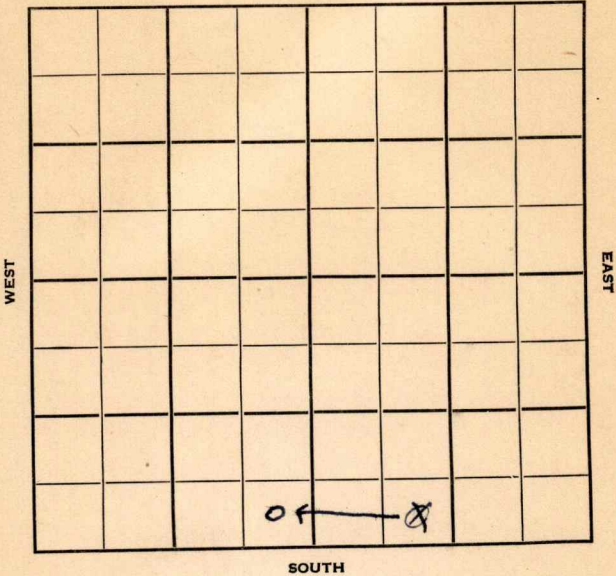

Rice

KANSAS

Sec. 27 Twp. 20 R. 6W ✓

Well No. #1 Wernett Farm

Inland Oil et al


Welch Pool Company

 Ft. from N. Line

330' Ft. from S. Line

330 Ft. from E. Line

990' Ft. from W. Line

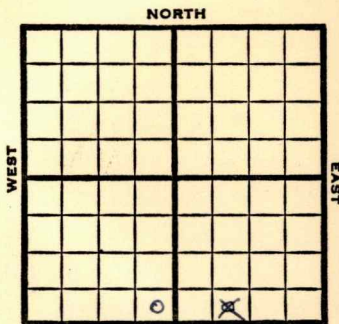

~~SE SW SE~~ SE SE SW.

1950

REPORT

1/18

Spud 1-14-50

8" @ 98'

Drlg. 1240'

2/1

TD 3433'

8" @ 98'

TD 3433 in Miss

Lans 2815'

Cong 3374'

Miss 3375'

D&A

Aband.

ABANDONED

Kansas

Welch Pool

Map No. _____ Sec. 27 Twp. 20 R. 6WWell No. 1 WernettInland Oil etal.

Company

Contractor

SE SW SE

SECTION PLAT

FIRST REPORT			

_____ Ft. from N. Line

330 Ft. from S. Line

_____ Ft. from E. Line

990 Ft. from W. LineRice County

Location _____

Rig up _____

Drilling and Remarks:

Spud 1-14-50

8" @ 98

drlg. 1240

RECORD

Cased _____ in., _____ ft.

Sand _____

Gas _____

Oil _____

Total Depth _____

PRODUCTION

1st 24 hrs. Nat. _____

1st 24 hrs. after shot _____

Gas _____ Cu. Ft.

Dry Hole _____

Abandoned _____


Date

JAN 18 1950 19J. E. TYRA

Scout

Map No. _____ Sec. 27 Twp. 20 R. 6WWell No. 1 Wernet_____D. T. Ingling_____
Company_____CORRECTION_____
Contractor

SE SE SW

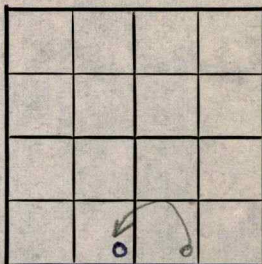El. 1603
SECTION PLAT_____Ft. from N. Line_____330 Ft. from S. Line_____330 Ft. from E. Line_____Ft. from W. Line

Rice County

Location _____

Rig up _____

Drilling and Remarks:

Reported

SE SW SE

RECORD

Cased _____ in., _____ ft.

Sand _____

Gas _____

Oil _____

Total Depth _____

PRODUCTION

1st 24 hrs. Nat. _____

1st 24 hrs. after shot _____

Gas _____ Cu. Ft.

Dry Hole _____

Abandoned _____

Date

JAN 25 1919 J. E. TYRA Scout


Map No. _____ Sec. 27 Twp. 20 R. 6WWell No. 1 WernettInland Oil etal.

Company

Contractor

SE SW SE

SECTION PLAT

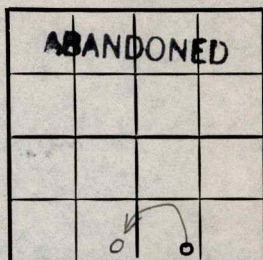

_____ Ft. from N. Line

330 Ft. from S. Line

_____ Ft. from E. Line

990 Ft. from W. LineRice County

Location _____

Rig up _____

Drilling and Remarks:

8" @ 98T.D. 3433 in miss.Lans 2815Cong 3374Miss 3375D & A

RECORD

Cased _____ in., _____ ft.

Sand _____

Gas _____

Oil _____

Total Depth 3433

PRODUCTION

1st 24 hrs. Nat. _____

1st 24 hrs. after shot _____

Gas _____ Cu. Ft.

Dry Hole _____

Abandoned _____

Date

FEB 1 1950J. E. TYRA19

Scout