


Section 27 Township 20 Range 8W

Well No. #1 Edgar

Company Tom Allen

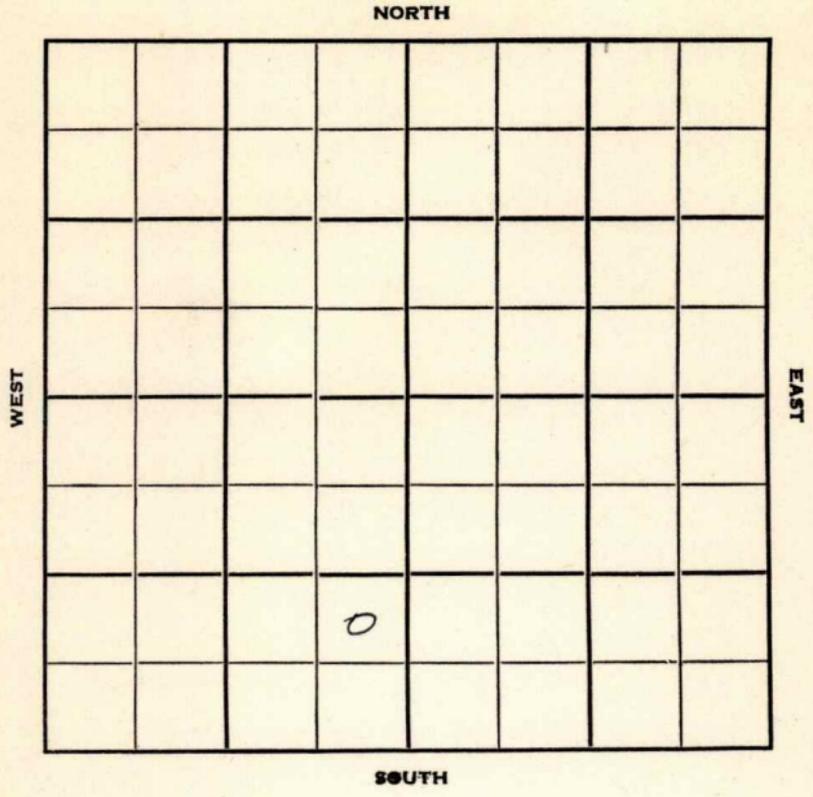

Rice

KANSAS

Sec. 27 Twp. 20 R. 8W

Well No. #1 Edgar Farm

Tom Allen Company

Contractor


Ft. from N. Line

990' Ft. from S. Line

330' Ft. from E. Line

Ft. from W. Line

NE SE SW

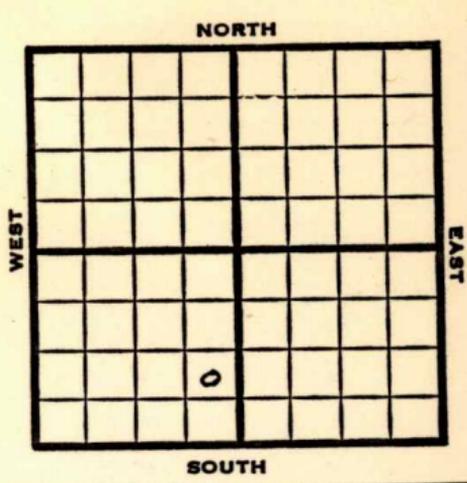

1951 **Elev. 1659'** REPORT

4/25 Location

5/23 Spud 4-25-51
Oil Well TD 3315
8" @ 205

Br Lime 2877 Lans. 2905

Cong. 3302-04

5" @ 3202 TD 3315

3/4 boph 14/3305-12

Comp. 16 bopd

COMPLETED

