


Section 28 Township 20 Range 8-W

Well No. #1 Hutchinson

Company Tom Allen

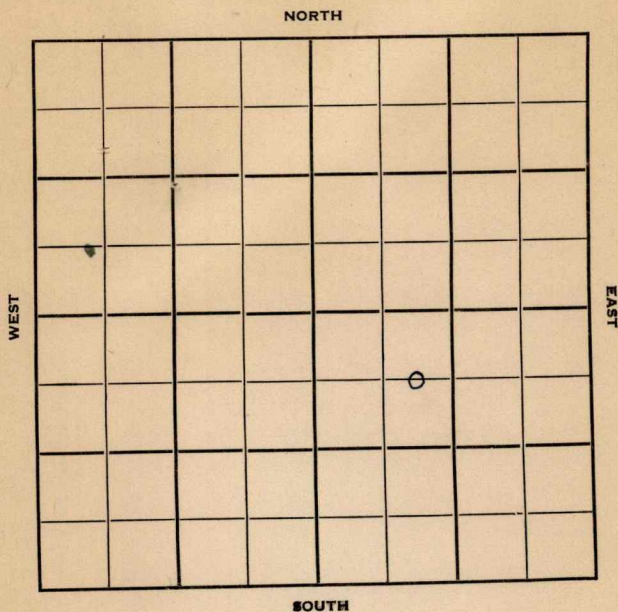

KANSAS

Rice

Sec. 28 Twp. 20 R. 8-W

Well No. #1 Hutchinson Farm

Tom Allen Company

Contractor

Yeast

660 Ft. from N. Line


_____ Ft. from S. Line

_____ Ft. from E. Line

990
330 Ft. from W. Line

~~C W L NW SE~~

C E L W W S E

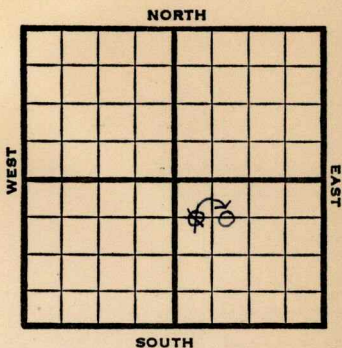

1950

Elev 1659

REPORT

7/19

MIM

8/30

8 5/8" @ 212

Anhy 204

Lans 2887

Cong. 3276-78

5" @ 3278

Viola 3369

Simp 3409-10 TD

TD 3410

D&A

ABANDONED

County Rice State KansasSec. 28 (Blk.
Twps.) 20 (Sur.
Rge.) 8W Map No.Operator Tom AllenWell No. 1 Farm HutchinsonElev. 1659 Location C E L NW SE660 Ft. From N Line SE990 Ft. From W Line Quarter

1st. Report

Completion AUG 30 1950

Remarks

Yeast Pool

Spudding Date

Drlg. Data D & A TD 34108 5/8" @ 212 Anhy 204 Lans. 2887Cong. 3276-78 5" @ 3278 Viola 3369Simp. 3409-10 TD D & A

Map No. _____ Sec. 28 Twp. 20 R. 8WWell No. 1 Hutchinson

Tom Allen

Company

CORRECTION

Contractor

C E L NW SE

SECTION PLAT

		o	

660 Ft. from N. Line

_____ Ft. from S. Line

_____ Ft. from E. Line

990 Ft. from W. Line

Rice County

Location _____

Rig up _____

Drilling and Remarks:

Reported

C W L NW SE

RECORD

Cased _____ in., _____ ft.

Sand _____

Gas _____

Oil _____

Total Depth _____

PRODUCTION

1st 24 hrs. Nat. _____

1st 24 hrs. after shot _____

Gas _____ Cu. Ft.

Dry Hole _____

Abandoned _____

Date

JUL 26 1950 19

J. E. TYRA

Scout

Kansas

Map No. _____ Sec. 28 Twp. 20 R. 8WWell No. 1 HutchinsonTom Allen

Company

Contractor

C W L NW SE

SECTION PLAT

660 Ft. from N. Line

_____ Ft. from S. Line

_____ Ft. from E. Line

330 Ft. from W. LineRice County

Location _____

Rig up _____

Drilling and Remarks:

M I M

RECORD

Cased _____ in., _____ ft.

Sand _____

Gas _____

Oil _____

Total Depth _____

PRODUCTION

1st 24 hrs. Nat. _____

1st 24 hrs. after shot _____

Gas _____ Cu. Ft.

Dry Hole _____

Abandoned _____

Date

JUL 19 1950

19

J. E. TYRA

Scout