


McPherson

Form 51-5M-11-31-Palace

Map No. **KANSAS** Sec. 28 Twp. 20 R. 3^W

Well No. 1-2 Tucker Farm
Linclair-Prairie Company

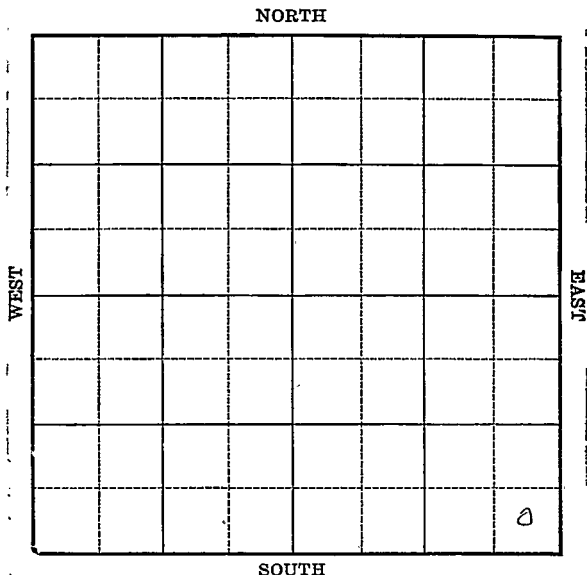

Location _____

Drilling Remarks _____

RECORD

Cased _____ in. _____ ft.

Sand _____

Gas _____

Oil _____

Total Depth _____

Rig Up _____

Drilling Remarks _____

PRODUCTION

1st 24 hrs. Nat. _____

1st 24 hrs. after shot _____

Gas _____ cu. ft.

Dry Hole _____


Abandoned _____

Map No. KANSAS Sec. 28 Twp. 20 R. 3^w

Well No. 1 - Turkey Farm

Sinclair - Prairie Company

NORTH

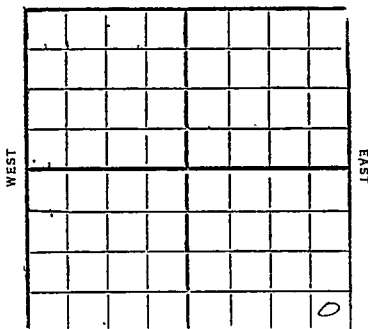

 Ft. from N. Line

330 Ft. from S. Line

330 Ft. from E. Line

 Ft. from W. Line

1932

SOUTH

Date REPORT

8/31	Cellar
9/7	Rig
9/14	" 15" - 110
	dreg 300'
9/21	" 1934
9/30	" 2670
10/5	Top Chat 3020
	Base line 3120
	Cem 8" 3019
	Viola 3344 - 48
	TD 3348' Rust
10/12	TD 3348
	dreg plug & Plug out
10/14	Top Green shale 3388
	" Wilcox 3398
	TD 3422
	Made 60 bbl
10/26	TD 3422' Setg engine
11/2	TD 3422
	Run 40 bbl per hr
	for first 4 hrs

43 KANSAS

Map No. _____ Sec. 28 Twp. 20 R. 3 W

Well No. 1 Stuckey

Sinclair-Oil Co. Company

Contractor

FIRST REPORTS

_____ Ft. from N. Line

330 Ft. from S. Line

330 Ft. from E. Line

_____ Ft. from W. Line

SECTION PLAT

			0

Location _____

Rig up _____

Drilling and Remarks:

Ocellar

RECORD

Cased _____ in., _____ ft.

Sand _____

Gas _____

Oil _____

Total Depth _____

PRODUCTION

1st 24 hrs. Nat. _____

1st 24 hrs. after shot _____

Gas _____ Cu. Ft.

Dry Hole _____

Abandoned _____

Date

McPherson

W

43 KANSAS

Map No. _____ Sec. 28 Twp. 20 R. 3

Well No. 1 Stuckey

Sinclair-Grainger Company

Contractor

COMPLETED

_____ Ft. from N. Line

330 Ft. from S. Line

330 Ft. from E. Line

_____ Ft. from W. Line

SECTION PLAT

RECORD

Location _____

Cased _____ in., _____ ft.

Sand 3398-3422

Gas _____

Oil _____

Total Depth 3422

Drilling and Remarks:

Potential Prod
974 Bbls 24 Hrs.

PRODUCTION

1st 24 hrs. Nat. _____

1st 24 hrs. after shot _____

Gas _____ Cu. Ft.

Dry Hole _____

Abandoned _____

Date

NOV 9

1932

CHAS. L. SHERWOOD

192

Scout

11/9- Sand 3398-3422

TID 3422

Potential prod

974 bbl 24 hr

Comp.