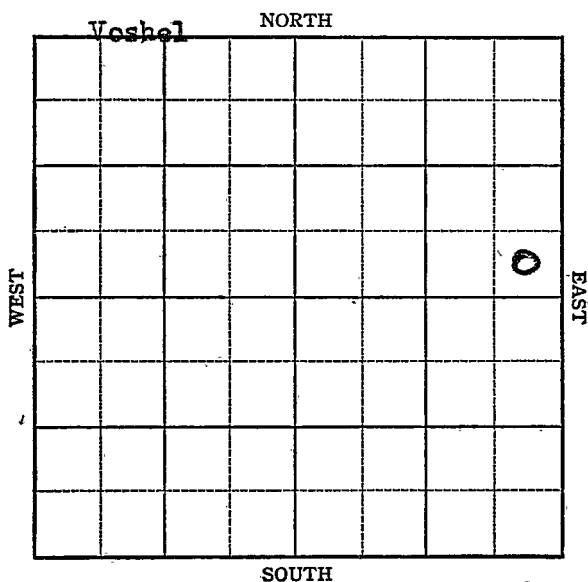


KANSAS

McPherson

FORM 51 IOM 12-46 PETROL

Section 28 Township 20 Range 3WWell No. 1 Stucky "B"Company Aylward Prod.

KANSAS

McPherson County

Sec. 28 Twp. 20 R. 3-W

Well No. 1 Stucky "B" Farm

Aylward Prod. Company

Voshel Pool


Ft. from N. Line

330 Ft. from S. Line

330 Ft. from E. Line

Ft. from W. Line

SE NE

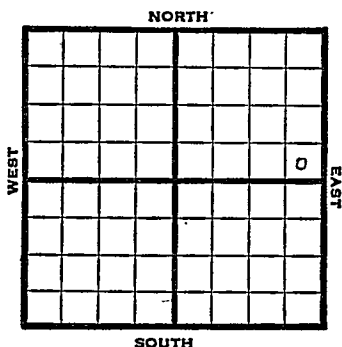

1947 Elev. 1462: REPORT

7/30 RUR

8/6 "

8/13 Viola 3318
Drlg. 3320'

8/20 Arbuckle 3454'
5" @ 3456'
TD 3480'

RUST
8/27 3100' oil 2½ hrs.

9/3 "

9/10 Arb. 3454'
5" @ 3456'
Pump 250 Pot
3810 Gr.
TD 3480'

COMPLETED

Map No. _____ Sec. 28 Twp. 20 R. 3W

Well No. 1 Stucky "B"

Aylward Prod. _____ Company

FIRST REPORT _____ Contractor

SE NE


SECTION PLAT

_____ Ft. from N. Line

330 Ft. from S. Line

330 Ft. from E. Line

_____ Ft. from W. Line

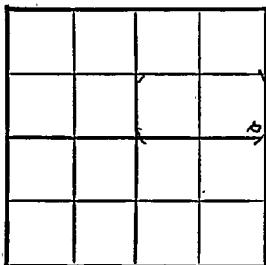

~~McPherson County~~

Location _____

Rig up _____

Drilling and Remarks:

R U R

RECORD

Cased _____ in., _____ ft.

Sand _____

Gas _____

Oil _____

Total Depth _____

PRODUCTION

1st 24 hrs. Nat. _____

1st 24 hrs. after shot _____

Gas _____ Cu. Ft.

Dry Hole _____

Abandoned _____

Date

JUL 30 1947 19

S. J. LEWIS Scout


Map No. 43 Sec. 28 Twp. 20 R. 3WWell No. 1 Stucky "B"

Aylward Prod. _____ Company

COMPLETE

Contractor

SE NE

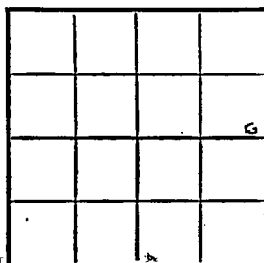E 11/462
SECTION PLAT

_____ Ft. from N. Line

330 Ft. from S. Line330 Ft. from E. Line

_____ Ft. from W. Line

McPherson County

Location _____

Rig up _____

Drilling and Remarks:

Cr 1345-4
5' @ 345-6Pump 250 Bbl08° 48'

RECORD

Cased _____ in. _____ ft.

Sand _____

Gas _____

Oil _____

Total Depth 3480

PRODUCTION

1st 24 hrs. Nat. _____

1st 24 hrs. after shot _____

Gas _____ Cu. Ft.

Dry Hole _____

Abandoned _____

Date

SEP 10 1947

19

S. J. LEWIS

Scout