

McPherson

Form 252-A
5M 4-32 MPC

Map No. KANSAS Sec. 28 Twp 20 R. 3W


Well No. 2 - S. J. Stucky Farm
Linclair-Prairie Company

_____ Ft. from N. Line

1320 Ft. from S. Line

330 Ft. from E. Line

_____ Ft. from W. Line

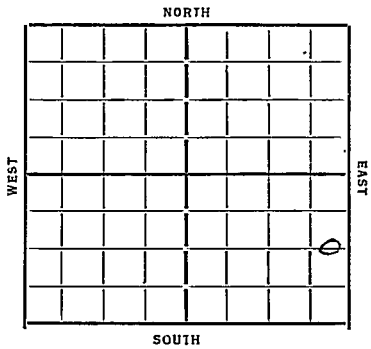

Date	REPORT
<u>1933</u>	
<u>10/25</u>	<u>Bldg Rig</u>
<u>11/1</u>	<u>Rigging up.</u>
<u>11/8</u>	<u>Drilg 425 15" at 209</u>
<u>11/15</u>	<u>" 1300'</u>
<u>11/22</u>	<u>T.D 1700' - Plug Back to 1500'</u>
<u>11/22</u>	<u>Drilg 1850</u>
<u>12/6</u>	<u>" 2836</u>
<u>12/12</u>	<u>Chat 2994 Viola 3292-6" 3296 PUS 73298</u>
<u>12/27</u>	<u>Viola 3285-3332</u>
	<u>Wilcox 3374</u>
	<u>1st oil 3381 - T.D. 3418</u>
	<u>600' oil 300' water</u>
	<u>Plug back to 3412</u>
<u>1/4</u>	<u>" " " 3400</u>
	<u>shot 20 gts - C. O</u>
<u>1/11</u>	<u>— 1/17 —</u>
<u>1/24</u>	<u>Wilcox 3374 T.D. 3418</u>
	<u>P.B. 3412</u>
	<u>233 oil</u>
	<u>330 water</u>

COMPLETED

Map No. 43 Sec. 28 Twp. 20 R. 3W

Well No. 2 - S. J. Stucky

Sinclair Prairie Company

Contractor

SECTION PLAT

..... Ft. from N. Line

1320 Ft. from S. Line

330 Ft. from E. Line

..... Ft. from W. Line

FIRST REPORTS

Location

Rig up.....

Drilling and Remarks:

B.R.

RECORD

Cased..... in., ft.

Sand.....

Gas.....

Oil.....

Total Depth.....

PRODUCTION

1st 24 hrs. Nat.....

1st 24 hrs. after shot.....

Gas..... Cu. Ft.

Dry Hole.....

Abandoned.....

Date

10-25-33 192 O. Mann Scout

Map No. 43 Sec. 28 Twp. 20 R. 3W

Well No. 2 - S. J. Stucky

Sundair-prairie Company

Contractor

COMPLETED

SECTION PLAT

			0

..... Ft. from N. Line

1320 Ft. from S. Line

330 Ft. from E. Line

..... Ft. from W. Lines

Location.....

Rig up.....

Drilling and Remarks:

P.B. 3412

*233 oil
330 water*

RECORD

Cased..... in., " ft.

Sand *3374*

Gas.....

Oil.....

Total Depth 3418

PRODUCTION

1st 24 hrs. Nat.....

1st 24 hrs. after shot.....

Gas..... Cu. Ft.

Dry Hole.....

Abandoned.....

Date

1-24-34 192 *O. Manschreck* Scout