


Section 28 Township 20 Range 6W

Well No. 1 Van Horn

Company Greenhand Drlg.

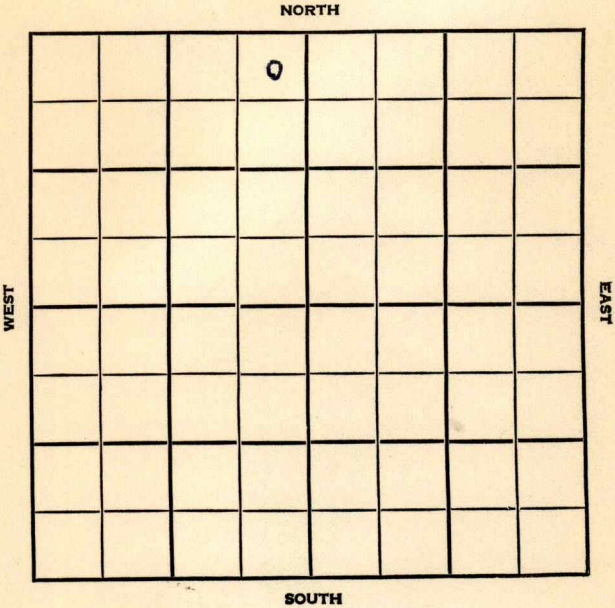

Rice KANSAS

SEC.	TWP.	R.
28	20	6W

WELL NO.

1 Van Horn

FARM

COMPANY

Greenland Drlg.

CONTRACTOR

Greenland Drlg.

Wildcat


330 Ft. from N. Line

Ft. from S. Line

330 Ft. from E. Line

Ft. from W. Line

NE NE NW

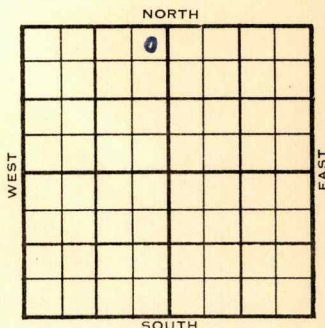

1955

ELEVATION

1632'

REPORT

3/9

Spud 3-4-55
10" @ 123'
Drlg. 1675'

4/27

Spud 3-4-55
D & A
TD 3421'
10" @ 123'

Miss 3386'

TD 3395'

DD 3421'

5" @ 3394' frac. HFW

D & A

ABANDONED

County Rice State Kansas
 Sec. 28 (Blk.) 20 (Sur.) 6W Map No.

Operator Greenland Drlg.

Well No. 1 Farm Van Horn

Elev. Location NE NENW

			0				

330 Ft. From N Line NW

330 Ft. From E Line Quarter

1st. Report MAR 9 1955

Completion

Remarks

Greenland Drlg. - Contr

Spudding Date 3-4-55

Drlg. Data Wildcat

10" @ 123 drlg. 1675

FABEN GILSTRAP

County Rice State Kansas
 Sec. 28 (Blk. 20 (Sur. 6W Map No.
 (Twp.) (Rge.)
 Operator Greenland Drlg.
 Well No. 1 Farm Van Horn
 Elev. 1632 Location NE NE NW

			0				

330 Ft. From N Line NW
330 Ft. From E Line Quarter

1st. Report

Completion APR 27 1955

Remarks Wildcat

Greenland Drlg. - Contr.

Spudding Date 3-4-55

Drlg. Data D & A TD 3421

10" @ 123 Miss. 3386 TD 3395

DD 3421 5" @ 3394 frac HFW

D & A

FABEN GILSTRAP