


Section 28 Township 20 Range 4W

Well No. #1 Smith

Company Trans-Era & Nate Appleman

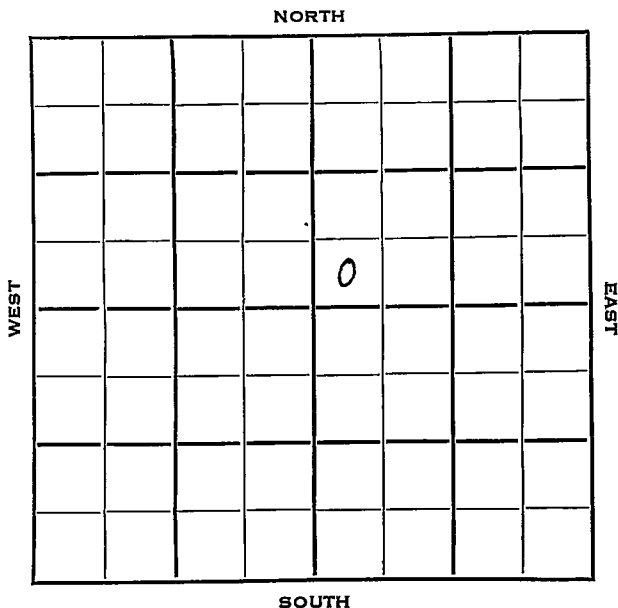

McPherson

WARRANTS

SEC.	28	TWP.	20	R.	LW
------	----	------	----	----	----

WELL NO. #1 Smith FARM

COMPANY Trans-Era & Nate Appleman

CONTRACTOR Trans Era

Wildcat.

Ft. from N. Line


330

Ft. from S. Line

Ft. from E. Line

330

Ft. from W. Line

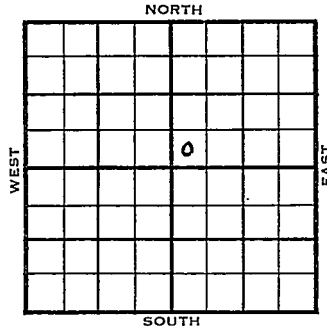

SW SW NE

Shell - support.


	ELEVATION	REPORT
1953	1481'	.

11/4 M I R
 11/11 13" @ 275'
 Drlg. 645'
 11/18 Lost slips in hole
 12/9 Spud 11-4-53
 D&A
 TD 3939'
 13" @ 275'
 8" @ 642'
 Br line 2538', Lans 2595', Miss 3257'
 Kh. 3544', Maq. 3768', Viola 3790',
 Simp. 3811', Arb. 3887'
 TD 3939'
 D&A

ABANDONED

J. G. McGEHEE

County McPherson State Kansas
 Sec. 28 (Blk.) 20 (Sur.) 4W Map No.
 Operator Trans-Era & Nate Appleman
 Well No. 1 Farm Smith
 Elev. 1481 Location SW SW NE

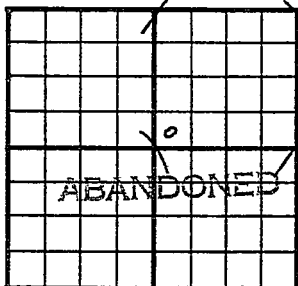

330 Ft. From S Line NE
330 Ft. From W Line Quarter

1st. Report

Completion DEC 9 1950

Remarks Wildcat

Trans-Era - Contr.

Spudding Date 11-4-53

Drilg. Data D & A TD 3939

13" @ 275 8" @ 642 Br. lime 2538

Lans. 2595 Miss. 3257 Kh. 3544

Maq. 3768 Viola 3790 Simp. 3811

Arb. 3887 TD 3939

D & A