
FORM 51 25M 8-50 WESTERN McPherson KANSAS

Section 29 Township 20 Range 1 W

Well No. # 1 John

Company W. L. Hartman

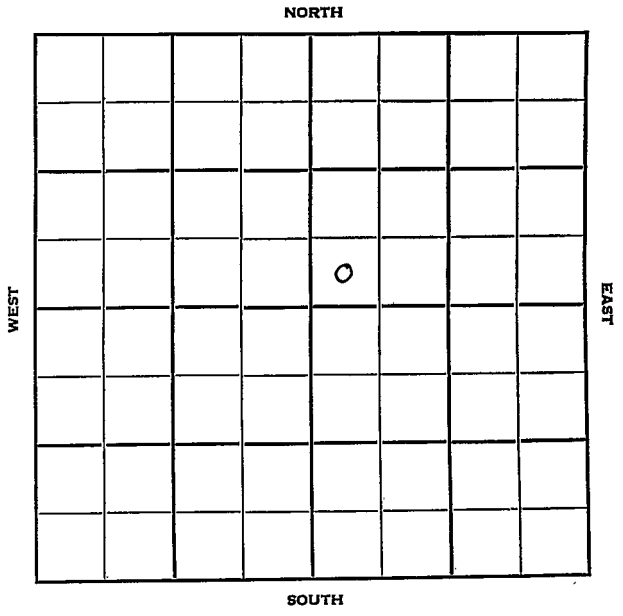

FORM 252-B
10M 11-50 PETROL

McPherson KANSAS

Sec. 29 Twp. 20 R. 1 W

Well No. # 1 John Farm

W. L. Hartman Company

Contractor

Wildcat


Ft. from N. Line

330 Ft. from S. Line

Ft. from E. Line

330 Ft. from W. Line

SW SW NE

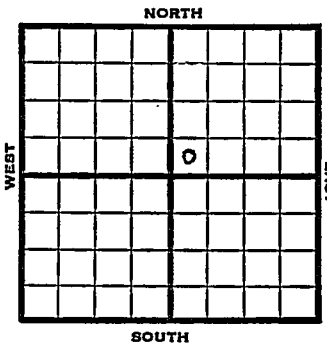

1951	Elev. 1536' REPORT
3/28	Location
5/23	Spud 4-5-51 D&A TD 3578 8" @ 169' KC 2334 DST 2451-59 opn 1 hr. Rec. 140' wtr Miss 2943 DST 2448-69 opn 1 hr Rec. 55' mud Top 1771' Heeb. 2084 Tor. 2098' Base Oread 2112 Lans. 2334 Miss 2943 DST 2997-3015 opn ½ hr Rec. 185' o & gcm Kinderhook 3246' Misenor 3418 Maq/3423 Viola 3448 Simp 3481 DST 3481-92 opn 1 hr Rec. 220' sw Simp 3495 Arb. 3566-78 5" @ 3056 4/3019-20 wtr 58/2996-3013 18 gw 1 goph 500 A 15 gw 1 goph SP 2992 21/2977-87 1000 A wtr SP 2974 22/2965-72 SP 2960 44/2944-56 wtr 2000 A wtr D&A **ABANDONED**

FORM 275 FOR SALE BY KANSAS BLUE PRINT CO.

County McPherson State Kansas

Sec. 29 (Blk. Twp.) 20 (Sur. Rge.) 1W Map No.

Operator W. L. Hartman

Well No. 1 Farm John

Elev. Location SW SW NE



330 Ft. From S Line NE

330 Ft. From W Line Quarter

1st. Report MAR 2 8 1951

Completion

Remarks

Spudding Date

Drlg. Data Wildcat

Location

J. E. TYRA

FORM 275 FOR SALE BY KANSAS BLUE PRINT CO.


County McPherson State Kansas

Sec. 29 (Blk. Twp.) 20 (Sur. Rge.) 1W Map No.

Operator W. L. Hartman

Well No. 1 Farm John

Elev. 1536 Location SW SW NE

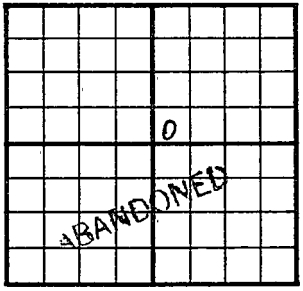

330 Ft. From S Line NE

330 Ft. From W Line Quarter

1st. Report

Completion MAY 23 1951

Remarks Wildcat

Spudding Date 4-5-51

Drlg. Data D & A TD 3578

8" @ 169 KC 2334 DST 2451-59

open 1 hr. Rec. 140' water Miss. 2943

DST 2448-69 open 1 hr. Rec. 55' mud

Top. 1771 Heeb. 2084 Tor. 2098

Base Oread 2112 Lans. 2334 Miss. 2943

DST 2975-92 open 1 hr. Rec. 10' mud

DST 2997-3015 open ½ hr. Rec. 185'

o & gcm Kinderhook 3246 Misenor 3418

Maq/ 3423 Viola 3448 Simp. 3481

DST 3481-92 open 1 hr. Rec. 220' sw

Simp. 3495 Arb. 3566-78 5" @ 3056

4/ 3019-20 water 58/ 2996-3013

18 gw 1 goph 500 A 15 gw 1 goph

SP 2992 21/ 2977-87 1000 A water

J. E. TYRA

Drlg. Data

SP 2974 22/ 2965-72 SP 2960 44/ 2944-56 water 2000 A water

D & A -

