


Section 29 Township 20 Range 5-WWell No. #1 ~~Malm~~ MatsonCompany ~~Mid-States~~ Nadel & Gussman

NORTH Bornholdt Pool

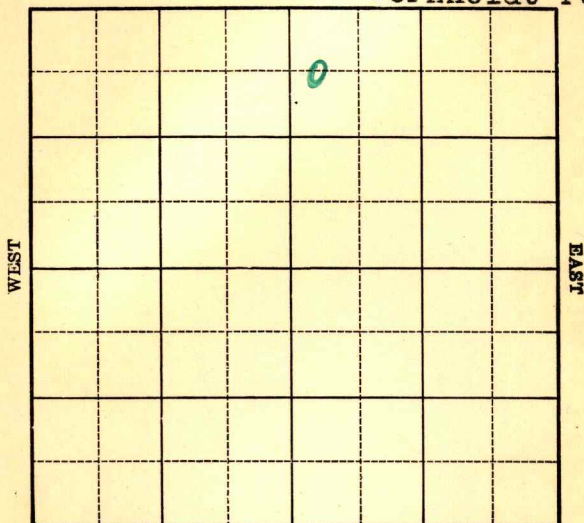

SOUTH

KANSAS

McPherson

Sec. 29 Twp. 20 R. 5-WWell No. #1 Malm Matson Farm~~Mid-States~~ Nadel & Gussman Company

(Bornholdt)

660

Ft. from N. Line


Ft. from S. Line

Ft. from E. Line

330

Ft. from W. Line

Elev. 1560

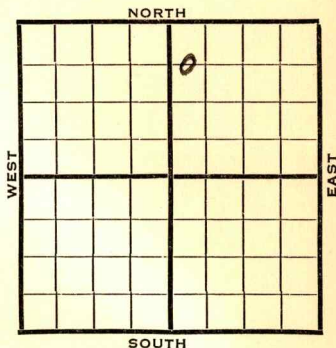

1940

REPORT

7/24 10" - 153' Drlg. 475'

8/2 Drlg. 2833'

8/8 Chat. 3405-07' T.D. SD for pipe.

8/14 5" 3406' RUST.

8/21 Chat. 3405'

5" - 3406'

T.D. 3407'

H.F.W.

ABANDONED

Map No. _____ Sec. **29** Twp. **20** R. **5W**Well No. **1 Malm****Mid-States**

Company _____

Contractor _____

FIRST REPORT**SECTION PLAT****C W L NW NE****660** Ft. from N. Line

_____ Ft. from S. Line

_____ Ft. from E. Line

330 Ft. from W. Line

BORNHOLDT POOL

Location _____

Rig up _____

Drilling and Remarks:

10" - 153**Drlg. 475****RECORD**

Cased _____ in., _____ ft.

Sand _____

Gas _____

Oil _____

Total Depth _____

PRODUCTION

1st 24 hrs. Nat. _____

1st 24 hrs. after shot _____

Gas _____ Cu. Ft.

Dry Hole _____

Abandoned _____

Date

JUL 24 1940 19**S. J. LEWIS** Scout

Map No. 48 Sec. 29 Twp. 20 R. 5WWell No. 1 MatsonNadel & Gussman CompanyCORRECTION Contractor

C W L NW NE

660 Ft. from N. Line Ft. from S. Line Ft. from E. Line330 Ft. from W. Line

BORNHOLDT POOL

SECTION PLAT

		o	

Location Rig up

Drilling and Remarks:

Reported as

#1 Malm,
Mid-States

RECORD

Cased in., ft.Sand Gas Oil Total Depth

PRODUCTION

1st 24 hrs. Nat. 1st 24 hrs. after shot Gas Cu. Ft.Dry Hole Abandoned

Date

AUG 6 1940

19

S. J. LEWIS

Scout

Map No. 48 Sec. 29 Twp. 20 R. 5WWell No. 1 MatsonNadel & Gossman Company

Contractor

ABANDONED**SECTION PLAT**

		0	

C W L NW NE660 Ft. from N. Line

_____ Ft. from S. Line

_____ Ft. from E. Line

330 Ft. from W. Line**BORNHOLDT POOL**

Location _____

Rig up _____

Drilling and Remarks:

*Cpa 83405**5" C 3406**X F.W.***RECORD**

Cased _____ in., _____ ft.

Sand _____

Gas _____

Oil _____

Total Depth 3402**PRODUCTION**

1st 24 hrs. Nat. _____

1st 24 hrs. after shot _____

Gas _____ Cu. Ft.

Dry Hole _____

Abandoned _____

Date

AUG 21 1940 19S. J. LEWIS Scout