

KANSAS

McPherson

Form 51—5M—7-39—Palace


Section 29 Township 20 Range 5-W

Well No. #2 Peterson

Company Ohio

Bornholdt Pool

NORTH

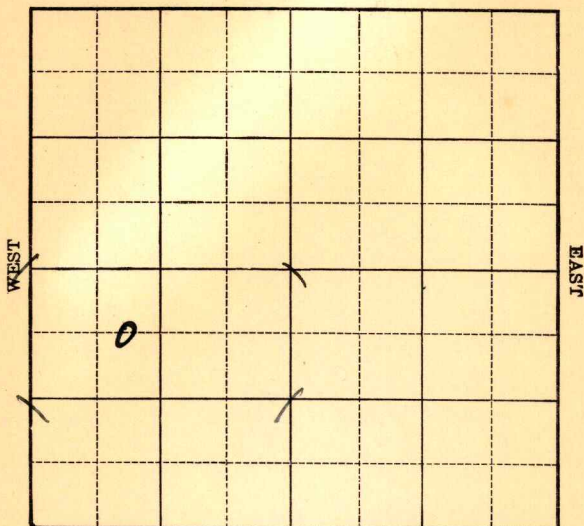

SOUTH

KANSAS

McPherson

Sec. 29 Twp. 20 R. 5 -WWell No. #2 Peterson FarmOhio

Company

(Bornholdt)

660


Ft. from N. Line

Ft. from S. Line

Ft. from E. Line

990

Ft. from W. Line

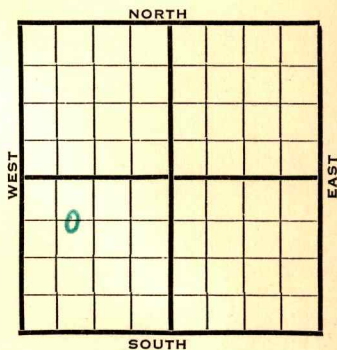

Elev. 1556

1940

REPORT

5/1 Location

5/9 Rigging up.

5/16 8" - 164' Drlg. 265'

5/23 Drlg. 2700'

5/29 Miss. 3353-54' T.D. 5" - 3353'

RUST.

6/5 Top Chat 3356 Dlg. 3403

2800' OIH 24 hrs. (Tel)

6/6 T.D. 3403' 2800' oil 24 hours.

Testing.

6/13 Shot 40 qts. 3376-90'

Swab 8½ bbls. oil & 7 water 2½

hours.

6/20 " " "

6/27 " " "

OVER

1940
7/2

Chat. 3353'

5" - 3353'

T.D. 3403'

Shot 40 qts. 3376-90'

P.B. to 3390'

Potential 113 bbls., pump.

COMPLETED

Map No. 48 Sec. 29 Twp. 20 R. 5WWell No. 2 PetersonOhio

Company

Contractor

FIRST REPORT

C E L NW SW

660 Ft. from N. Line Ft. from S. Line Ft. from E. Line990 Ft. from W. Line

SECTION PLAT

BORNHOLDT POOL

Location XRig up

Drilling and Remarks:

RECORD

Cased in., ft.Sand Gas Oil Total Depth

PRODUCTION

1st 24 hrs. Nat. 1st 24 hrs. after shot Gas Cu. Ft.Dry Hole Abandoned

Date

MAY 1 1940

19

S. J. LEWIS

Scout

Map No. 48 Sec. 29 Twp. 20 R. 5WWell No. 2 PetersonOhio

Company

Contractor

COMPLETED

C E L NW SW

660 Ft. from N. Line Ft. from S. Line Ft. from E. Line990 Ft. from W. Line

BORNHOLDT POOL

SECTION PLAT

0			

Location Rig up

Drilling and Remarks:

Cha 833535" @ 33534096 3376-90P.B. 3390Pump 113 P.S.**RECORD**Cased in., ft.Sand Gas Oil Total Depth 3403**PRODUCTION**1st 24 hrs. Nat. 1st 24 hrs. after shot Gas Cu. Ft.Dry Hole Abandoned

Date

JUL 2 1940 19S. J. LEWIS Scout