


LOCATION NOTICE

TULSA, OKLA., February 1, 1940 193

WELL NO. Two (2) ON Christina Peterson FARM

WILL BE AS FOLLOWS:

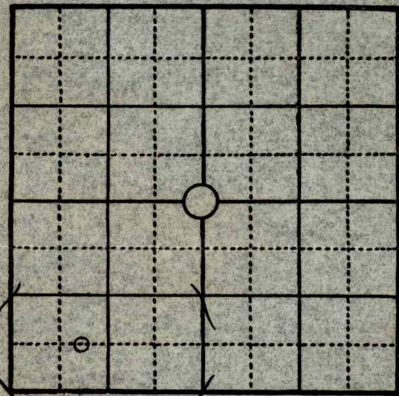

660

FEET FROM NORTH LINE

FEET FROM EAST LINE

FEET FROM SOUTH LINE

990

FEET FROM WEST LINE

IN S. 1/4 SW 1/4 SEC. 29 TWP. 20S RANGE 5W

McPherson COUNTY, STATE OF Kansas

REMARKS: Operated by MCRC; MCRC interest, all.

District Supt. - Lloyd Snyder.

Foreman - S. K. McLanahan

SIGNED [Signature]

COPIES TO

DISTRICT SUPT.
ACCOUNTING DEPT.
RENTAL DEPT.
SCOUTING DEPT.
ENGINEERING DEPT.
LEGAL DEPT.
CLAIM DEPT.
TAX DEPT.
GEOLOGICAL DEPT.
FILE
LEASE INVENTORY
Purchasing Dept.

road map
small map
RAY

REPORT OF PRODUCING WELL ABANDONED

Well No. 2 Farm Name Christina Peterson
Description S/2 SW/4 Sec. 29-20S-5W
County McPherson State Kansas
Date Plugging Completed May 1, 1951
Last well on the lease.

Accounting Dept.
Rental Dept.
✓ Scouting Dept.
Engineering Dept.
Legal Dept.
Lease Inventory Man
Tax Dept.
Purchasing Dept.
Income Tax Dept.
Pipe Line Dept.
File

A. E. Pierce
w