

KANSAS

Form 51—5M—7-39—Palace


McPherson

Section 29 Township 20 Range 5-W

Well No. #2 Christina Peterson

Company Mid-Continent Petroleum

NORTH Bornholdt Pool

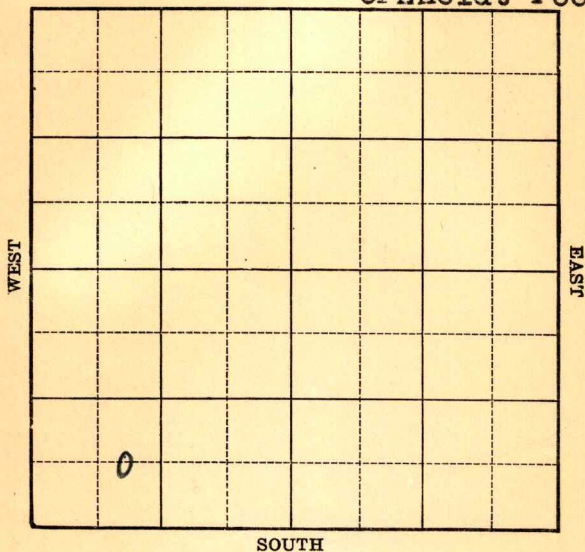


Sec. 29 Twp. 20-S R. 5-WWell No. #2 Christina Peterson FarmMid-Continent Petroleum Corp. Company  
(Bornholt)

Ft. from N. Line

660 Ft. from S. Line

Ft. from E. Line

990 Ft. from W. Line

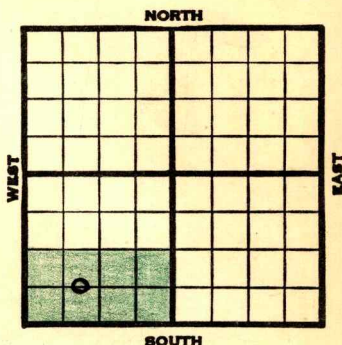

Elev. 1551

1940	REPORT
2/1	Location (Location notice)
2/5	Digging cellar and pits
2/13	10" 215 Dlg. ahead (Tel)
2/15	215' of 10". Drlg. 410'
2/20	T.D. 2430 Have been shut down account storm Now preparing to start up (Tel)
2/23	Drlg. 2610'
2/23	Dlg. 2980 (Tel)
2/26	<sup>3348</sup> <del>3348</del> <sup>3354</sup> <del>3353</del> Top Chat <del>3348</del> T.D. <del>3353</del> Odor oil
	Running 7" <sup>3351</sup> <del>3350</del> 3350 (Tel)
	Running <sup>12 11'</sup> <del>11'</del> lower on Chat than #1 Peterson west offset which was completed for a bottom hole bomb potential of 4402 bbls.
	Running 15' lower on Chat than Ohio #1 Peterson to northwest a 15 bbl minimum well
2/26	<sup>3348</sup> Correction: Top Chat <del>3348</del>
	T.D. <sup>3353</sup> <del>3354</del> 7" <sup>3350</sup> <del>3351</del> Odor oil (Tel)
2/27	Correction: Top Chat 3348 odor oil
	T.D. 3353 7" 3350 WOC (Tel)
2/28	Rust (Tel)
3/4	Bailing mud this afternoon Will drill plugs tomorrow morning (Tel)

OVER

OVER

OVER

1940

3/27

Chat 3348'

7" - 3349'

T.D. 3386 $\frac{1}{2}$ '

Shot 20 qts. 3370-85 $\frac{1}{2}$ '

Potential 277 bbls., pump.

1941

COMPLETED

8/9--Pumping potential 158 bbls. (Tel)



Map No. 753 Sec. 29 Twp. 20 R. 5WWell No. 2 Christina PetersonMid-Continent Petroleum Company

Contractor


## FIRST REPORT

C E L SW SW

         Ft. from N. Line660 Ft. from S. Line         Ft. from E. Line990 Ft. from W. Line

BORNHOLDT POOL

## SECTION PLAT

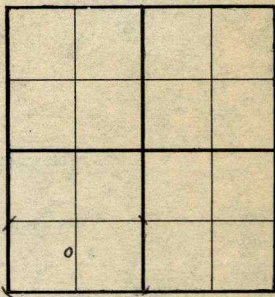Location                         Rig up                         

Drilling and Remarks:

Building derrick

## RECORD

Cased                  in.,                  ft.Sand                         Gas                         Oil                         Total Depth                         

## PRODUCTION

1st 24 hrs. Nat.                         1st 24 hrs. after shot                         Gas                          Cu. Ft.Dry Hole                         Abandoned                         

Date

FEB 7 1940 19

S. J. LEWIS

Scout

Map No. 48 Sec. 29 Twp. 20 R. 5WWell No. 2 Christina PetersonMid-Continent Petroleum

Company

Contractor

**COMPLETED****C E L SW SW****SECTION PLAT**


\_\_\_\_\_ Ft. from N. Line

660 Ft. from S. Line

\_\_\_\_\_ Ft. from E. Line

990 Ft. from W. Line**BORNHOLDT POOL**

Location \_\_\_\_\_

**RECORD**

Cased \_\_\_\_\_ in., \_\_\_\_\_ ft.

Sand \_\_\_\_\_

Gas \_\_\_\_\_

Oil \_\_\_\_\_

Total Depth 3386 1/2**PRODUCTION**

1st 24 hrs. Nat. \_\_\_\_\_

1st 24 hrs. after shot \_\_\_\_\_

Gas \_\_\_\_\_ Cu. Ft.

Dry Hole \_\_\_\_\_

Abandoned \_\_\_\_\_

Rig up \_\_\_\_\_

Drilling and Remarks:

*Chas 3348.**7" C 3348**20 gts 3370-85 1/2**Pump. 277 B.D.*

Date

MAR 27 1940 19

S. J. LEWIS

Scout



14000 32623  
April 8978

- 3/6--**Top Chat 3348** 7" 3349  
First Oil 3370 T.D. 3380  
Filled up 250 feet oil in 3 hours  
Will drill 3 feet deeper, let set over  
night, and give swabbing test (Tel)
- 3/7--Storm came up Snowed and rained Trouble  
with belt coming off Clutch burned out  
Tools hanging in hole (Tel)
- 3/7--T.D. 3380 Tools out Have 1250 feet oil  
in hole Filled up at rate of 2 bbls. per  
hour Drill 3' deeper, swab till morning,  
then deepen 3 feet (Tel)
- 3/9--T.D. 3380 Swab 2 bbls. per hour for 3  
hours Swabbing off bottom Drilled deeper  
to T.D. 3386 $\frac{1}{2}$  Did not help Filled up  
600 feet oil in 7 hours Will shoot with  
20 qts. (Tel)
- 3/11--Shot 20 qts. Fishing sand pump (Tel)
- 3/12--Fishing job over Cleaning out (Tel)
- 3/13--Cleaning out 7' off bottom  
T.D. 3386 $\frac{1}{2}$  (Tel)
- 3/15--Cleaning out (Tel)
- 3/16--Cleaning out (Tel)
- 3/18--Swab 59 bbls. oil & 8 bbls. water 24 hrs.  
" 60 " " " " " " " "  
Running tubing today (Tel)
- 3/21--Pumped 92 bbls. in 8 hours  
24 hour potential 277 bbls.  
Water exhausted Showed no water at end  
of 8th hour (Tel)

OVER