

KANSAS

Rice


Form 51-5M-7-40-Palace

Section 3 Township 20 Range 9-W

Well No. #1 Keesling

Company Bay Petroleum

NORTH Keesling Pool

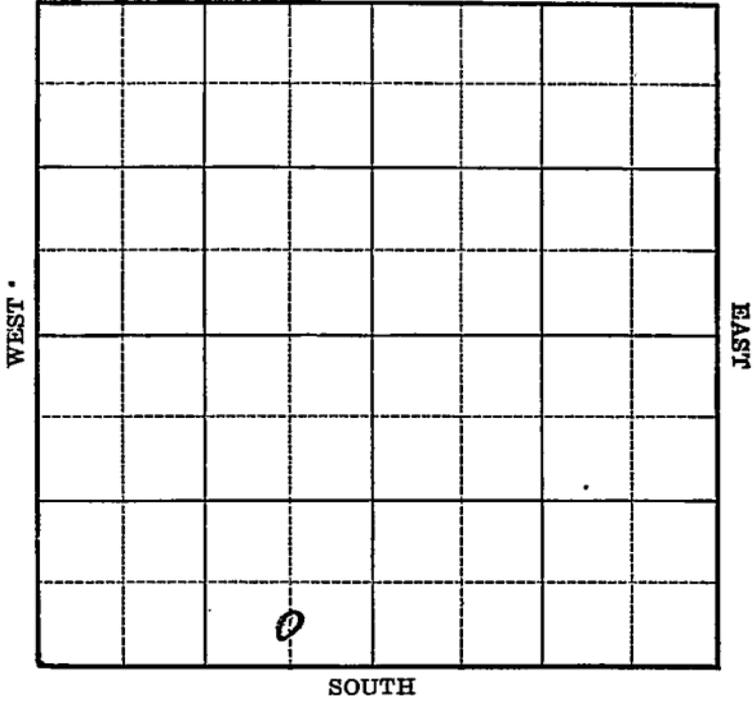

Sec. 3 Twp. 20 R. 9-W

Well No. #1 Keesling Farm

Bay Petr. Company

(Keesling)


_____ Ft. from N. Line

330 Ft. from S. Line

660 Ft. from E. Line

_____ Ft. from W. Line

Elev. 1698

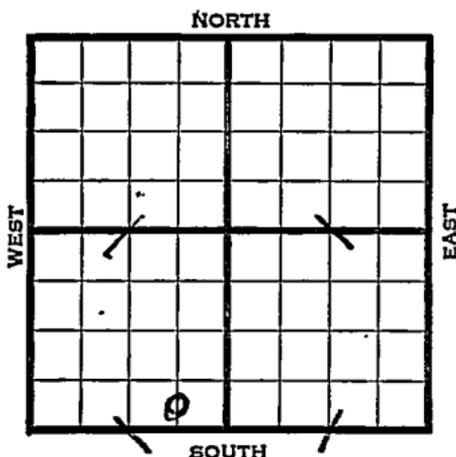

1940	REPORT
11/20	Rotary .
11/27	8" - 216' Drlg. 1702'
12/5	Dodge 2849' Lans. 2868'
	Drlg. 3205'
12/12	Arb. 3209' 5" - 3215'
	T.D. 3224' 2800' oil 12 hours.
12/18	Arb. 3209'
	5" - 3215'
	T.D. 3224'
	5000 acid.
	Potential 450 bbls., pump.
	43.8 Gravity
	COMPLETED

Map No. 49 Sec. 3 Twp. 20 R. 9WWell No. 1 KeeslingBay Petroleum Company

Contractor


FIRST REPORT

C S L SE SW

 Ft. from N. Line330 Ft. from S. Line660 Ft. from E. Line Ft. from W. Line

KEESLING POOL

SECTION PLAT

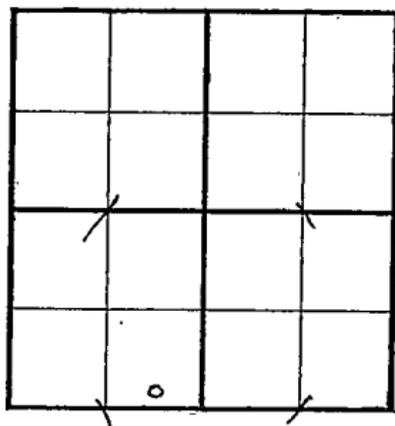Location Rig up

Drilling and Remarks:

Rotary

RECORD

Cased in., ft.Sand Gas Oil Total Depth

PRODUCTION

1st 24 hrs. Nat. 1st 24 hrs. after shot Gas Cu. Ft.Dry Hole Abandoned

Date

NOV 20 1940 19

S. J. LEWIS

Scout

Map No. 29 Sec. 3 Twp. 20 R. 9WWell No. 1 KeeslingBay Petroleum Company

Contractor

COMPLETED

C S L SE SW

 Ft. from N. Line330 Ft. from S. Line660 Ft. from E. Line Ft. from W. Line

KEESLING POOL

SECTION PLAT

Location Rig up

Drilling and Remarks:

*Cr. 3209**5" @ 3215'**5000 acid**Pump. 450 Pot**48.5 Gr.*

RECORD

Cased in., ft.Sand Gas Oil Total Depth 3224

PRODUCTION

1st 24 hrs. Nat. 1st 24 hrs. after shot Gas Cu. Ft.Dry Hole Abandoned

Date

DEC 18 1940 19S. J. LEWIS Scout