

KANSAS

Form 51-5M-7-40-Palace


Rice.

Section 3 Township 20 Range 9-W

Well No. #2 Keesling

Company Bay Petroleum

NORTH Keesling Pool

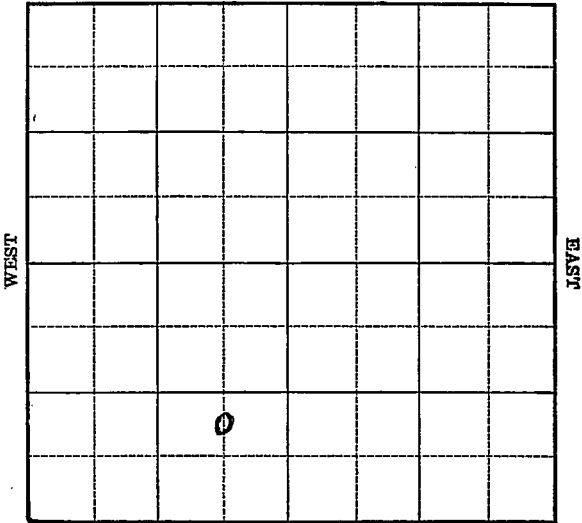

SOUTH

Sec. 3 Twp. 20 R. 9-W

Well No. #2 Keesling Farm

Bay Petr. Company

(Keesling)


_____ Ft. from N. Line

99.0 Ft. from S. Line

66.0 Ft. from E. Line

_____ Ft. from W. Line

Wlev. 1693

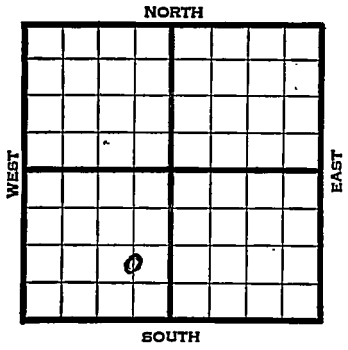

1940	REPORT
12/18	Rotary.
12/26	8" - 220' Drlg. 1670'
1941	
1/2	Lans. 2882' Drlg. 3015'
1/8	Arb. 3206'
	5" - 3208'
	T.D. 3221½'
	500 acid.
	Potential 450 bbls., pump.
	43.8 Gravity
	COMPLETED

Map No. 49 Sec. 3 Twp. 20 R. 9WWell No. 2 Keesling

Bay Petroleum

Company

Contractor

COMPLETED

C N L SE SW

_____ Ft. from N. Line

990 Ft. from S. Line660 Ft. from E. Line

_____ Ft. from W. Line

SECTION PLAT

KEESLING POOL

Location _____

Rig up _____

Drilling and Remarks:

*Cor 83206**5" @ 3208.**500 acid**Pump 450 Pst.**43.5 Gr*

RECORD

Cased _____ in., _____ ft.

Sand _____

Gas _____

Oil _____

Total Depth 3221 1/2

PRODUCTION.

1st 24 hrs. Nat. _____

1st 24 hrs. after shot _____

Gas _____ Cu. Ft.

Dry Hole _____

Abandoned _____

Date

JAN 8 1941

S. J. LEWIS Scout