

KANSAS

Rice


Form 51-5M-7-40-Palace

Section 3 Township 20 Range 9-W

Well No. #3 Keesling

Company Bay Petroleum

NORTH Keesling Pool

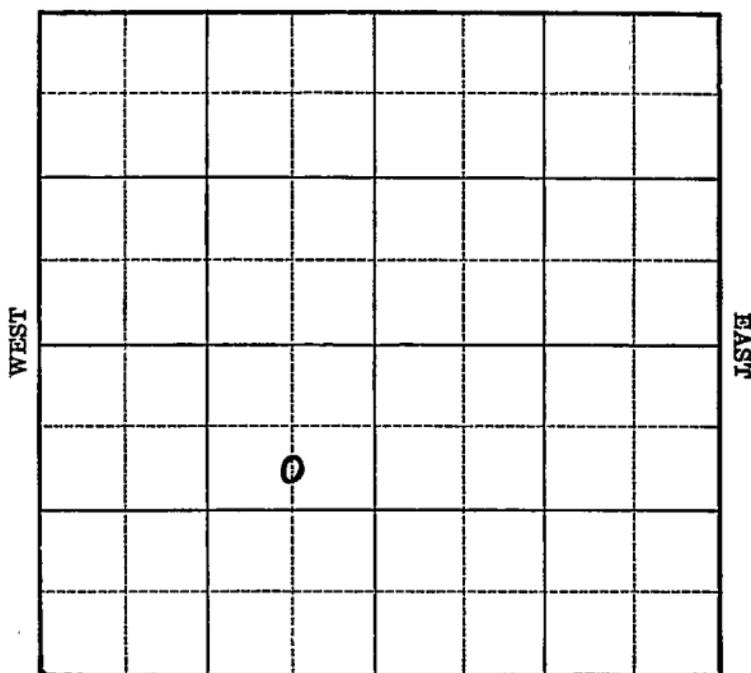

SOUTH

Sec. 3 Twp. 20 R. 9-W

Well No. #3 Keesling Farm

Bay Petr. Company

(Keesling)


990 Ft. from N. Line

_____ Ft. from S. Line

660 Ft. from E. Line

_____ Ft. from W. Line

Elev. 1686

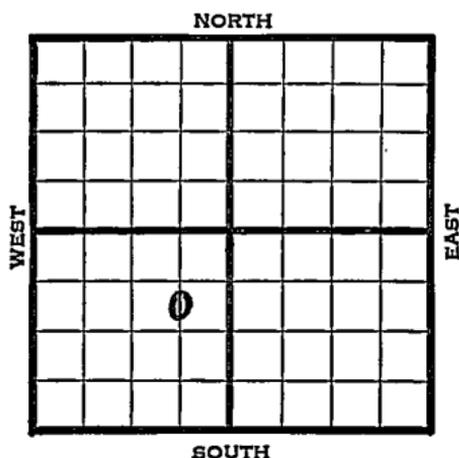

1941	REPORT
3/19	Rotary.
3/27	8" - 196' Drlg. 2408'
4/3	Arb. 3215' 5" - 3217' T.D. 3221' RUST.
4/9	Arb. 3215'
	5" - 3217'
	T.D. 3233'
	Potential 121 bbls., pump.
	43.8 Gravity
	COMPLETED

Map No. 49 Sec. 3 Twp. 20 R. 9WWell No. 3 KeeslingBay Petroleum

Company

~~COMPLETED~~

Contractor

SECTION PLAT

C S L NE SW

990 Ft. from N. Line

_____ Ft. from S. Line

660 Ft. from E. Line

_____ Ft. from W. Line

KEESLING POOL

Location _____

Rig up _____

Drilling and Remarks:

*Core 8215**5" @ 8217**Pump 121 P & X**43 E 92*

RECORD

Cased _____ in., _____ ft.

Sand _____

Gas _____

Oil _____

Total Depth 8233

PRODUCTION

1st 24 hrs. Nat. _____

1st 24 hrs. after shot _____

Gas _____ Cu. Ft.

Dry Hole _____

Abandoned _____

Date

APR 9 1941 19

S. J. LEWIS

Scout