

KANSAS

FORM 51 5M 4-41 PETROL


Rice

Section 3 Township 20 Range 9-W

Well No. #1 Specht

Company Auto Oridnance

NORTH Keesling Pool

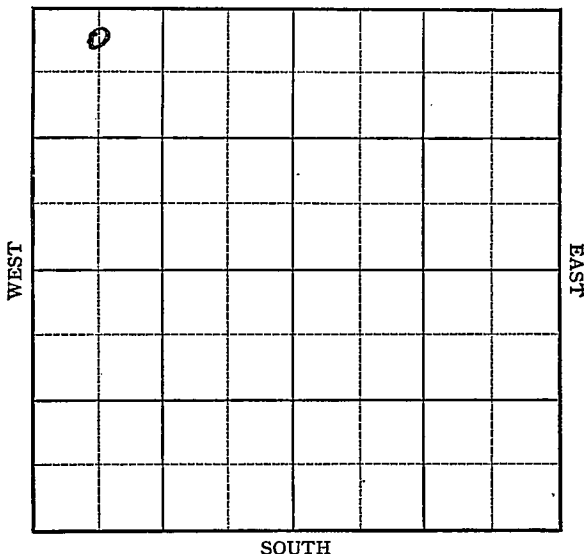

KANSAS

Rice

Sec. 3 Twp. 20 R. 9-W

Well No. #1 Specht Farm

Auto Ordinance Company

(Keesling)


330 Ft. from N. Line

_____ Ft. from S. Line

_____ Ft. from E. Line

660 Ft. from W. Line

Elv. 1682

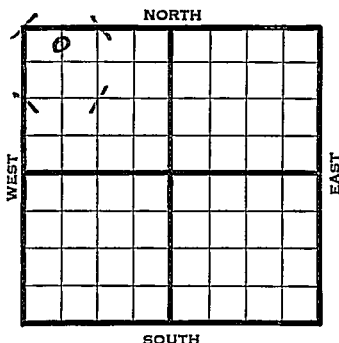

1942

REPORT

6/17 8" - 178' WOC.

6/24 Drlg. 2400'

7/1 Arb. 3217' T.D. 3226' 5" - 3218'

RUST.

7/8 T.D. 3233' 4000 acid. No help.

Shot 10 qts. 3223 $\frac{1}{2}$ -30 $\frac{1}{2}$ ' C.O.

7/15 Arb. 3217'

5" - 3218'

T.D. 3233'

Shot 10 qts. 3223 $\frac{1}{2}$ -30 $\frac{1}{2}$ '

4000 acid.

Water.

ABANDONED

Map No. 49 Sec. 3 Twp. 20 R. 9WWell No. 1 Specht

Auto Ordinance

Company

FIRST REPORT

Contractor

C NL NW NW

SECTION PLAT

0			

330 Ft. from N. Line

_____ Ft. from S. Line

_____ Ft. from E. Line

660 Ft. from W. Line

KEESLING POOL

RECORD

Location _____

Cased _____ in., _____ ft.

Rig up _____

Sand _____

Drilling and Remarks:

Gas _____

8" - 178'

Oil _____

Total Depth _____

Waiting on cement

PRODUCTION

1st 24 hrs. Nat. _____

1st 24 hrs. after shot _____

Gas _____ Cu. Ft.

Dry Hole _____

Abandoned _____

Date

JUN 17 1942

19

S. J. LEWIS

Scout

KANSAS

Rice

Map No. 49 Sec. 3 Twp. 20 R. 9WWell No. 1 SpechtAuto Ordnance CompanyABANDONED Contractor

C NL NW NW

SECTION PLAT

330 Ft. from N. Line Ft. from S. Line Ft. from E. Line660 Ft. from W. Line

0			

KEESLING POOL

Location Rig up

Drilling and Remarks:

Ar 8217
5" @ 3218.
10' to 3223 1/2 - 30 1/2
4000 acid
Water.

RECORD

Cased in., ft.Sand Gas Oil Total Depth 3283

PRODUCTION

1st 24 hrs. Nat. 1st 24 hrs. after shot Gas Cu. Ft.Dry Hole Abandoned

Date

JUL 15 1942 19S. J. LEWIS Scout