
McPherson KANSAS

SECTION 23 TOWNSHIP 20 RANGE 2W

WELL NO. #2 Frank Unruh

COMPANY Geo. Hess, etal

NE NW NE

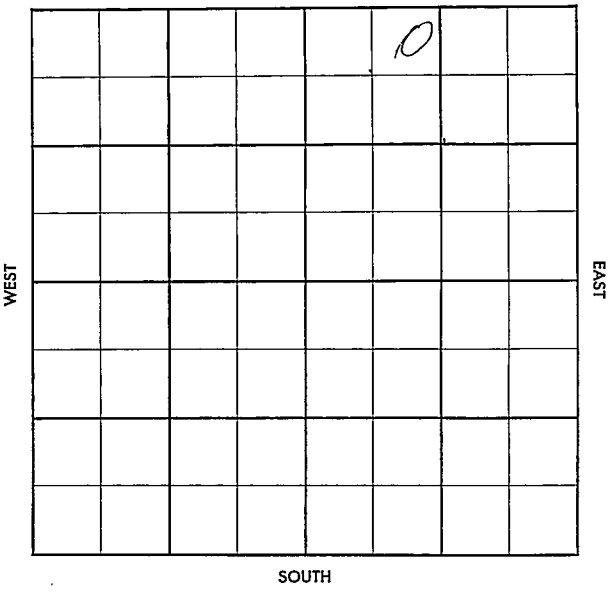

FORM 504-3 SUNRAY

FORM 513 SUNRAY

County McPherson Elev.

Sec. 2 Twp. 20 Rge. 2W

Company Geo. Hess etal

Farm Name Frank Unruh No. 2

TOPS	DEPTH	LOG	DATUM
Anh.			
Tp.			
H.			
Tr.			
Dg.			
Bl.			
L.			
K.C.			
B.K.C.			
Ce.			
C.			
M.			
M.			
K.			
Mz.			
Mo.			
V.			
S.			
S.			
A			
R.			
P€.			
G.			
T.D.			

Loc. in Sec. NE NW NE

Geol.

Contr. Veeder Supply

Pool Ritz-Canton

APR 17 '57

FIRST REPORT

Date Comm. MIRT

Co.

Lse.

No.

Sec.

T.

R.

FORM 513 SUNRAY

CORRECTION

County Nickerson Elev. 1541 DF

Sec. 28 Twp. 20 Rge. 24

Company Geo. Hess etal

FarmName Frank Unruh No. 2

TOPS	DEPTH	LOG	DATUM
Anh.			
Tp.			
H.			
Tr.			
Dg.			
Bl.			
L.	2314		
K.C.			
B.K.C.			
Ce.			
C.			
M. Chat	2944		
M.			
K.			
Mz.			
Mo.			
V.			
S.			
S.			
A			
R.			
P€.			
G.			
T.D.	2947		

Loc. in Sec. NE NW NE

Geol.

Contr. Veeder Sup

Pool Ritz-Canto

COMPLETE

MAY 8 '57

Date Comm.

MIRT APR 24 '57 4-16-57 8 5/8 143

1110 D 2900 MAY 1 '57 5 1/2 2944/S

WOC DO 2965 TD 8

1/2 Bopd + wtr Pot P. 25

Bopd + wtr.