

McPherson

KANSAS

SECTION 3 TOWNSHIP 20 RANGE 2W

WELL NO. #1 H.P. Unruh


COMPANY Jess Cling
Bradley-Tickel

NORTH

NW NWE
~~G NW NE~~

WEST

EAST

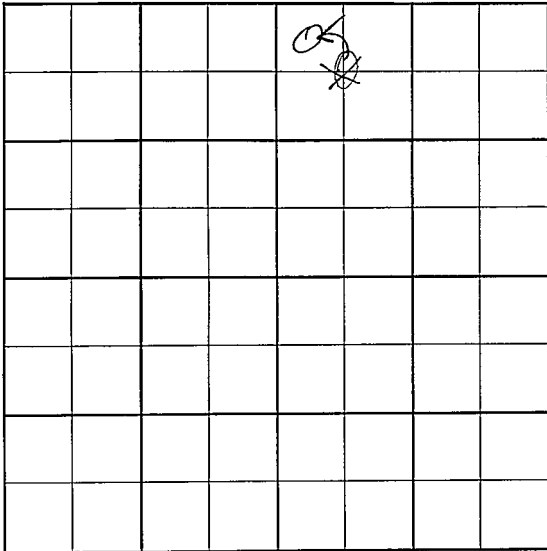

SOUTH

County McPherson

Elev. _____

Sec. 3 Twp. 20Rge. 2WCompany Bradley-TickelFarm Name H. P. UnruhNo. 1

TOPS

DEPTH

LOG

DATUM

Loc. in Sec. _____

Anh. _____

Tp. _____

H. _____

Tr. _____

Dg. _____

Bl. _____

L. _____

K.C. _____

B.K.C. _____

Ce. _____

C. _____

M. _____

M. _____

K. _____

Mz. _____

Mq. _____

V. _____

S. _____

S. _____

A. _____

R. _____

Pe. _____

G. _____

Geol. _____

Contr. _____

Melland Tools

Pool _____

Ritz Canton

		0	
FIRST REPORT			
FEB 20 '57			

Date Comm. 2-17-57

8" @ 120/100 Drlg. 1032

Co.

[

No.

Sec.

T.

R.

CORRECTION

FORM 513, SUNRAY

Co.

County McPherson Elev. 1538
 Sec. 3 Twp. 20 Rge. 2W
 Company Bradley-Tickel Jess Cling
 FarmName H. P. Unruh No. 1

TOPS	DEPTH	LOG	DATUM	Loc. in Sec.
Anh.				GNW NE
TP.				<u>NW NW NE</u>
H.				
Tr.				
Dg.				
Bl.				
L.				
K.C.				Geol.
B.K.C.				Contr.
Ce.				<u>Melland Tool</u>
C.				Pool
M.	<u>2940</u>			<u>Ritz Canton</u>
M.				
K.				
Mz.				
Mq.				
V.				
S.				
S.				
A.				
R.				
PE.				
G.				
T.D.	<u>2943</u>			

Log

No.

Sec.

T.

R.

		0
	APR 3 '57	

COMPLETE

Date Comm. 2-17-57

8" @ 120/100 Drlg. 1032 FEB 27 '57 MISS

2940 RTD 2943 5 1/2 @ 2942

MICET CO. 57 X 11 1/2 434 13 '57

U. 32057 ✓ MAR 27 '57 ✓ APR 3 '57 DD 2961

TD 1/2 POP P. 19 Bopd

+ wtr.