

KANSASSection 3 Township 20S Range 3WWell No. #1 Johnson "C"Company Casebeer

NORTH

WEST

							Q
					/		.
/							

EAST

SOUTH

KANSAS

McPherson ✓

Sec. 3 Twp. 20 R. 3-W

Well No. #1 Johnson "G" Farm.

Casebeer

Company

Cont- Uhl Drlg

330

Johnson

Ft. from N. Line .


Ft. from S. Line

330

Ft. from E. Line

Ft. from W. Line

NE/C

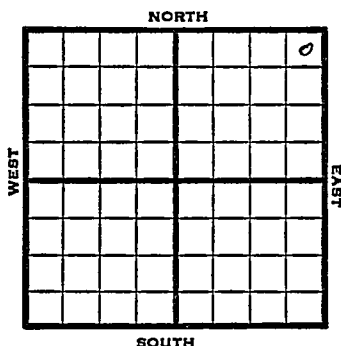

1949	Elev 1496'	REPORT
10/12	Location	
10/19	8"@ 218'	
	Drlg 3008'	
10/26	"	
11/1	Miss 2992'	
	TD 3007'	
	5" @ 3002'	
11/9	TD 3083'	
	1 bbls oil 24 hrs.	
11/16	6000 acid	
11/23	42 cone shots 3000-3018 CO	
11/29	"	
12/7	TD 3083'	
	Miss 2992'	
	Aband.	
	ABANDONED	
1950		
5/10	Miss. 2999	O. W. D. D
	5" @ 3003	
	O T D 3086	
	D. D. 3170 Sq. 5"	
	W. O. G.	
	OVER	

1950

7/5 Miss 2999'
5" - @ 3003'
OTD 3086 -
Viola 3386
4" Diner - @ 3449'
Simp 3496
TD 3584
217' of $3\frac{1}{2}$ " liner
Acid 3000
Comp. 120 BWPH
SWD

ABANDONED

Map No. _____ Sec. 3 Twp. 20 R. 3W

Well No. 1 Johnson "C"

_____ Casebeer _____ Company

_____ Uhl Drlg. _____ Contractor

NE/C


FIRST REPORT
SECTION PLAT

_____ 330 Ft. from N. Line

_____ Ft. from S. Line

_____ 330 Ft. from E. Line

_____ Ft. from W. Line

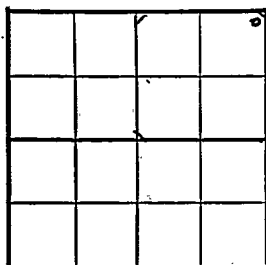

McPherson County

Location X

Rig up _____

Drilling and Remarks:

RECORD

Cased _____ in., _____ ft.

Sand _____

Gas _____

Oil _____

Total Depth _____

PRODUCTION

1st 24 hrs. Nat. _____

1st 24 hrs. after shot _____

Gas _____ Cu.Ft.

Dry Hole _____

Abandoned _____

Date

OGT 12 1949

19

S. J. LEWIS

Scout

Kansas

Map No. _____ Sec. 3 Twp. 20 R. 3WWell No. 1 Johnson "C"

Casebeer _____ Company

ABANDONED

Contractor

NE/C

E11496

SECTION PLAT

330 Ft. from N. Line

_____ Ft. from S. Line

330 Ft. from E. Line

_____ Ft. from W. Line

McPherson County

			6

Location _____

Rig up _____

Drilling and Remarks:

Miss 2992

RECORD

Cased _____ in., _____ ft.

Sand _____

Gas _____

Oil _____

Total Depth 2083

PRODUCTION

1st 24 hrs. Nat. _____

1st 24 hrs. after shot _____

Gas _____ Cu. Ft.

Dry Hole _____

Abandoned _____

Date

DEC 7 1949

19

S. J. LEWIS

Scout

Kansas O. W. D. D

Map No. _____ Sec. 3 Twp. 20 R. 3WWell No. 1 Johnson C

_____ Casebeer _____ Company

_____ Contractor

NE NE NE

El. 1496


SECTION PLAT

330 Ft. from N. Line

_____ Ft. from S. Line

330 Ft. from E. Line

_____ Ft. from W. Line

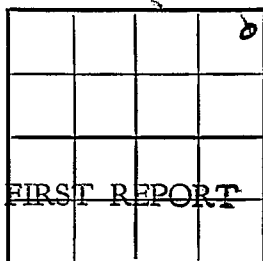

McPherson

Location _____

Rig up _____

Drilling and Remarks:

Mile. 2999

5" @ 3003

O T D 3086

D. D. 3170 Sq. 5"

W. O. C.

RECORD

Cased _____ in., _____ ft.

Sand _____

Gas _____

Oil _____

Total Depth _____

PRODUCTION

1st 24 hrs. Nat. _____

1st 24 hrs. after shot _____

Gas _____ Cu. Ft.

Dry Hole _____

Abandoned _____

Date

MAY 10 1950

19

J. E. TYRA Scout

Map No. _____ Sec. 3 Twp. 20 R. 3W

Well No. 1 Johnson "C"

Casebeer Company

Contractor

NE NE NE

El. 1496


SECTION PLAT

330 Ft. from N. Line

_____ Ft. from S. Line

330 Ft. from E. Line

_____ Ft. from W. Line

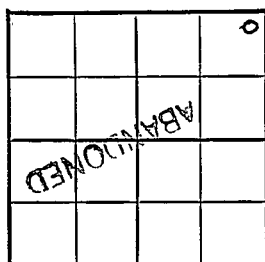

McPherson County

Location _____

Rig up _____

Drilling and Remarks:

Miss. 2999

5" C 3003

OTD 3086

Viola 3386

4" liner C 3449

Sirp. 3496

TD 3584

RECORD

Cased _____ in., _____ ft.

Sand _____

Gas _____

Oil _____

Total Depth 3584

PRODUCTION

1st 24 hrs. Nat. _____

1st 24 hrs. after shot _____

Gas _____ Cu. Ft.

Dry Hole _____

Abandoned _____

Date

JUL 5 1950 19

J. E. TYRA

Scout

150

AS

217' of 3 $\frac{1}{2}$ " liner

3000 acid

Comp. 120 bwph

STD

Scout Cards
Land Small Map
Land Wall Map
Tracing
France Map
Pierce Map
Misc.

JUN 7 1960

REC-30
