


Section 30 Township 20 Range 5-W

Well No. #2 Matson

Company Bradley Bros. & Blair

NORTH Bornholdt Pool

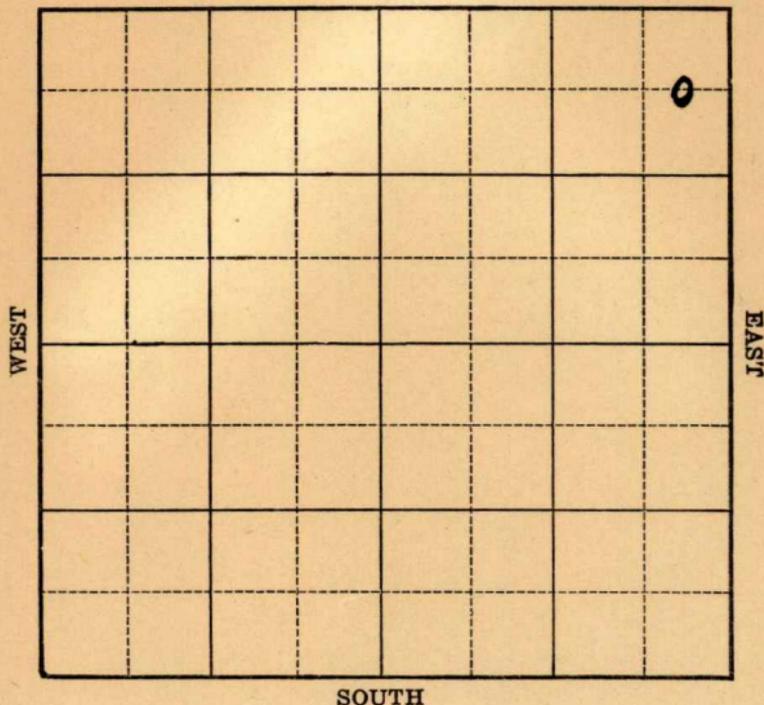

SOUTH

Sec. 30 Twp. 20 R. 5-W

Well No. #2 Matson Farm

Bradley Bros. & Blair Company


(Borhholdt)

~~990~~ 660 Ft. from N. Line

Ft. from S. Line

330
~~660~~ Ft. from E. Line

Ft. from W. Line

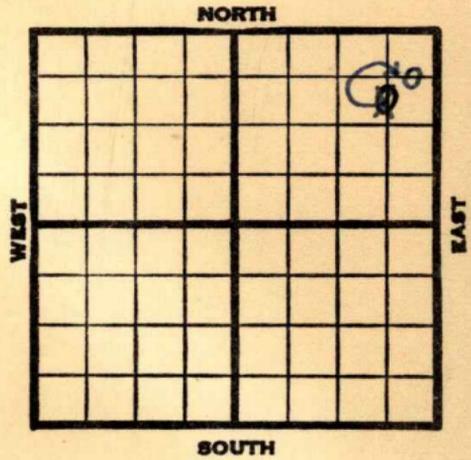

Elev. 1540

1939	REPORT
12/27	Material.
1940	
1/4	ROG.
1/11	"
1/18	"
1/25	"
2/1	"
2/8	R.U.R.
2/15	10" - 149'
	Drlg. 1750'
2/23	Drlg. 2950'
2/29	Chat. 3318' T.D. 3328'
	7" - 3321' RUST.
3/8	" " "
3/14	T.D. 3356' Flow 85 bbls. 1 hr.
3/20	Chat 3318'
	7" - 3321'
	T.D. 3357'
	Bomb potential 9258 bbls.
	Maximum 3000 bbls.
	COMPLETED

Map No. 48 Sec. 30 Twp. 20 R. 5W

Well No. 2 Matson

Bradley Bros & Blair Company

FIRST REPORT Contractor

C S L N E N E

SECTION PLAT

990 Ft. from N. Line

			o

_____ Ft. from S. Line

660 Ft. from E. Line

_____ Ft. from W. Line

BORNHOLDT POOL

Location _____

RECORD

Rig up _____

Cased _____ in., _____ ft.

Drilling and Remarks:

Sand _____

Material

Gas _____

Oil _____

Total Depth _____

PRODUCTION

1st 24 hrs. Nat. _____

1st 24 hrs. after shot _____

Gas _____ Cu. Ft.

Dry Hole _____

Abandoned _____

Date

DEC 27 1939 19

S. J. LEWIS Scout

Map No. 48 Sec. 30 Twp. 20 R. 5W

Well No. 2 Matson

Bradley Bros. & Blair Company

Contractor

COMPLETED


SECTION PLAT

660 C E L N E N E
Ft. from N. Line

_____ Ft. from S. Line

330 Ft. from E. Line

_____ Ft. from W. Line

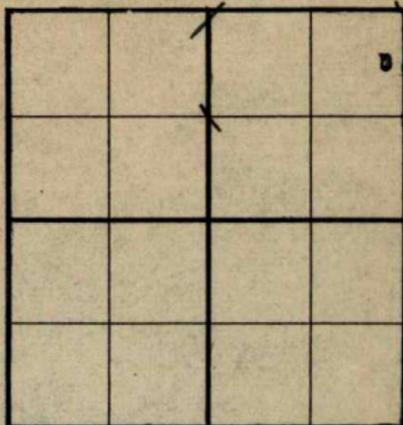

Bornholdt Pool

Location _____

Rig up _____

Drilling and Remarks:

Cha 3315

7" @ 3321.

Born. Pool 9255.

Matson 3000

RECORD

Cased _____ in., _____ ft.

Sand _____

Gas _____

Oil _____

Total Depth 3357

PRODUCTION

1st 24 hrs. Nat. _____

1st 24 hrs. after shot _____

Gas _____ Cu. Ft.

Dry Hole _____

Abandoned _____

Date

MAR 20 1940 19

S. J. LEWIS

Scout

Map No. 48 Sec. 30 Twp. 20 R. 5W

Well No. 2 Matson

Bradley Bros. & Blair Company

CORRECTION Contractor

C E L N E N E

SECTION PLAT

660 Ft. from N. Line

_____ Ft. from S. Line

330 Ft. from E. Line

_____ Ft. from W. Line

			o

BORNHOLDT POOL

Location _____

Rig up _____

Drilling and Remarks:

Reported

C S L N E N E

RECORD

Cased _____ in., _____ ft.

Sand _____

Gas _____

Oil _____

Total Depth _____

PRODUCTION

1st 24 hrs. Nat. _____

1st 24 hrs. after shot _____

Gas _____ Cu. Ft.

Dry Hole _____

Abandoned _____

Date

DEC 27 1939 19

S. J. LEWIS Scout