

KANSAS

Form 51—5M—7-39—Palace


McPherson

Section 30 Township 20 Range 5-W

Well No. #3 Matson

Company Sunray

NORTH Bornholdt Pool

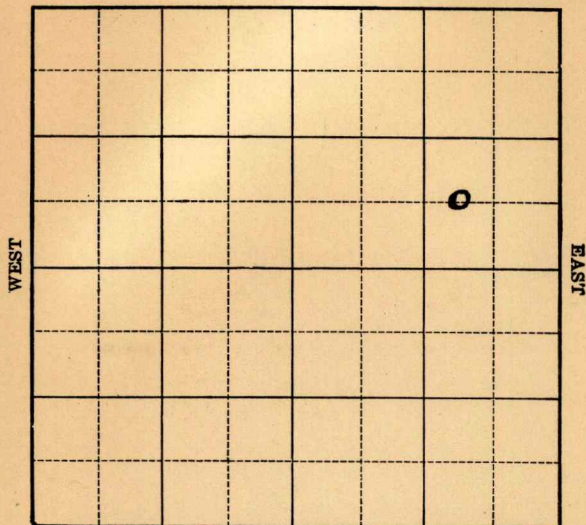

SOUTH

Sec. 30 Twp. 20 R. 5-W

Well No. #3 Matson Farm

Sunray

Company

(Bornholdt)


Ft. from N. Line

660 Ft. from S. Line

990 Ft. from E. Line

Ft. from W. Line

Elev. 1545

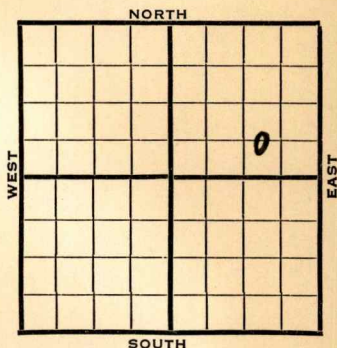[illegible]

Map No. 48 Sec. 30 Twp. 20 R. 5WWell No. 3 MatsonSunray

Company

Contractor

FIRST REPORT

C W L S E N E

 Ft. from N. Line660 Ft. from S. Line990 Ft. from E. Line Ft. from W. Line

SECTION PLAT

			o

BORNHOLDT POOL

Location Rig up

Drilling and Remarks:

10 " - 160WOC

RECORD

Cased in., ft.Sand Gas Oil Total Depth

PRODUCTION

1st 24 hrs. Nat. 1st 24 hrs. after shot Gas Cu. Ft.Dry Hole Abandoned

Date

JUN 5 1940 19S. J. LEWIS Scout

Map No. 48 Sec. 30 Twp. 20 R. 5WWell No. 3 MatsonSunray

Company

Contractor

COMPLETED

C W L S E N E

 Ft. from N. Line660 Ft. from S. Line990 Ft. from E. Line Ft. from W. Line**SECTION PLAT**

			0

BORNHOLDT POOL

Location Rig up

Drilling and Remarks:

*Cha & 3318**7" @ 3320**Born & R & 63388**May 3000***RECORD**Cased in., ft.Sand Gas Oil Total Depth 3366**PRODUCTION**1st 24 hrs. Nat. 1st 24 hrs. after shot Gas Cu. Ft.Dry Hole Abandoned

Date

JUL 10 1940 19S. J. LEWIS Scout