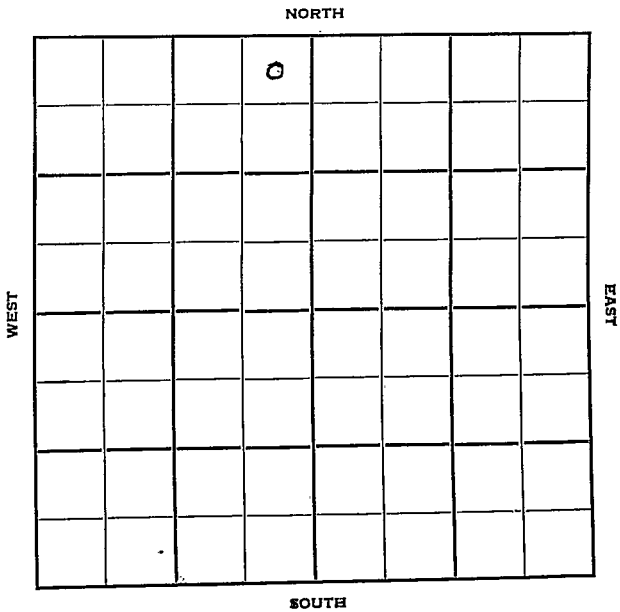


Section 30 Township ~~21~~²⁰ Range 1-WWell No. #1 OtteCompany H & H Drlg.

Sec. 30 Twp. 21 20 R. 1W

Well No. #1 Otto Farm

H & H Drlg. Company

Wildcat Contractor


330' Ft. from N. Line

Ft. from S. Line

330' Ft. from E. Line

Ft. from W. Line

NE NE NW

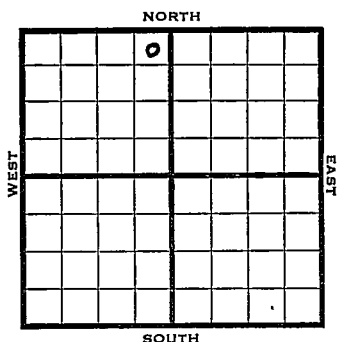

1950 Elev 1543 REPORT

8/16 Location

9/20 Spud 9-3-50

8" @ 165

Lans 2332

Simp 3526

Simp sd 3532

TD 3664


D&A

Miss 2994

Viola 3501

Arb 3598

ABANDONED

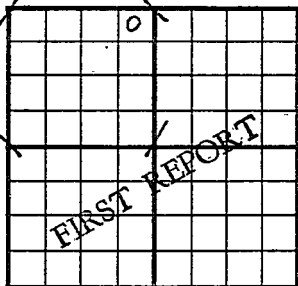County McPherson State KansasSec. 30 (Blk. Twp.) 21 (Sur. Rge.) 1W Map No.Operator H & H Drlg.Well No. 1 Farm OtteElev. Location NE NE NW330 Ft. From E Line NW330 Ft. From E Line Quarter1st. Report AUG 16 1956

Completion

Remarks

Texas & Skelly DHM

Spudding Date

Drlg. Data WildcatLocation

J. E. TYRA

Map No. _____ Sec. 30 Twp. 20 R. 1WWell No. 1 Otte

_____ H & H Drlg. _____ Company

CORRECTION

_____ Contractor

NE NE NW


SECTION PLAT

330 Ft. from N. Line

_____ Ft. from S. Line

330 Ft. from E. Line

_____ Ft. from W. Line

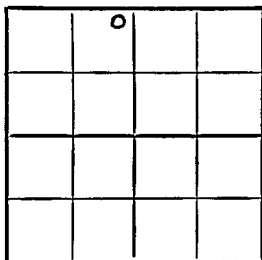

McPherson County

Location _____

Rig up _____

Drilling and Remarks:

Reported

30-21-1W

RECORD

Cased _____ in., _____ ft.

Sand _____

Gas _____

Oil _____

Total Depth _____

PRODUCTION

1st 24 hrs. Nat: _____

1st 24 hrs. after shot _____

Gas _____ Cu. Ft.

Dry Hole _____

Abandoned _____


Date

SEP 13 1950

19

J. E. TYRA

Scout

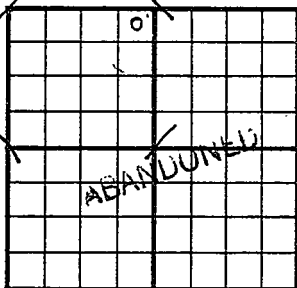County McPherson State KansasSec. 30 (Blk.
Twp.) 20 (Sur.
Rge.) 1W Map No.Operator H & H Drlg.Well No. 1 Farm OtteElev. 1543 Location NE NE NW330 Ft. From N Line NW330 Ft. From E Line Quarter1st. Report ~~SEP 20 1950~~Completion SEP 20 1950

Remarks

WildcatSpudding Date 9-3-50Drlg. Data D & A TD 36648" @ 165 Lans. 2332 Miss. 2994Simp. 3526 Viola 3501 Simp. sd. 3532Arb. 3598 TD 3664 D & A