

KANSAS

McPherson


Form 51—5M—7-40—Palace

Section 30 Township 20 Range 5-W

Well No. #4 Bornholdt

Company Moulton et al

NORTH Bornholdt Pool

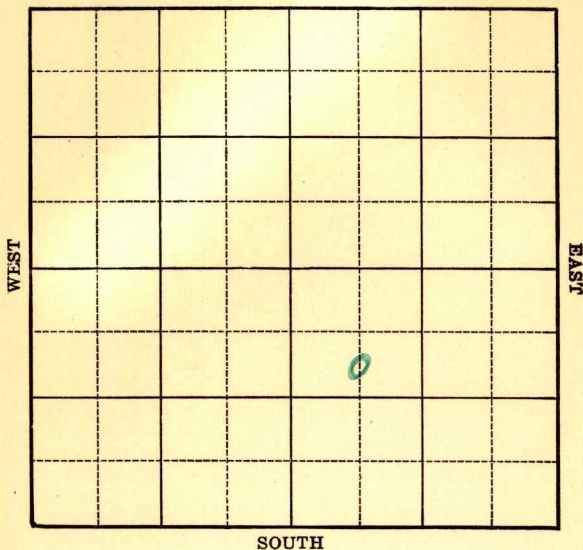

O.W.D.D.


Sec. 30 Twp. 20 R. 5-WWell No. #4 Bornholdt FarmMoulton et al

Company

(Bornholdt)

990 Ft. from N. Line Ft. from S. Line Ft. from E. Line660 Ft. from W. Line

Elev. 1544

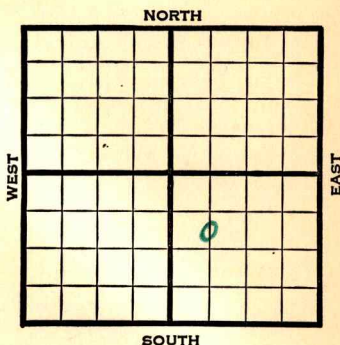

1940	REPORT	O.W.D.D.
10/9	8" - 159'	
	Dr1g. 1858'	
10/17	Chat. 3317'	5" - 3318' RUST.
10/24	T.D. 3354'	Flow 76 bbls. 1 hour
10/30	Chat. 3317'	
	5" - 3318'	
	T.D. 3354'	
	Bomb potential 1926 bbls.	
	COMPLETED	
1940	O.W.D.D.	
11/6	Old T.D. 3354'	
	T.D. 3365'	
	Pay 3362-65'	
	Flow 140 bbls. per hour.	
	OVER	

1940

11/13

OTD 3354'

Pay 3362-65'

T.D. 3365'

Bomb potential 35,610 bbls.

Maximum 3000 bbls.

COMPLETED

Map No. 48 Sec. 30 Twp. 20 R. 5WWell No. 4 BornholdtMoulton etal Company

Contractor

FIRST REPORT

SECTION PLAT


990 C S L NW SE
Ft. from N. Line

Ft. from S. Line

Ft. from E. Line

660 Ft. from W. Line

BORNHOLDT POOL

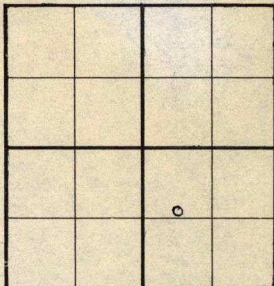

Location _____

Rig up _____

Drilling and Remarks:

8" - 159

Drilling 1858

RECORD

Cased _____ in., _____ ft.

Sand _____

Gas _____

Oil _____

Total Depth _____

PRODUCTION

1st 24 hrs. Nat. _____

1st 24 hrs. after shot _____

Gas _____ Cu. Ft.

Dry Hole _____

Abandoned _____

Date

OCT 9 1940S. J. LEWIS Scout

Map No. 48 Sec. 30 Twp. 20 R. 5WWell No. 4 BornholdtMoulton etal

Company

Contractor

COMPLETED

C S L NW SE

990 Ft. from N. Line Ft. from S. Line Ft. from E. Line660 Ft. from W. Line

BORNHOLDT POOL

SECTION PLAT

Location Rig up

Drilling and Remarks:

Ok 433175" @ 3318Bornholdt1926

RECORD

Cased in., ft.Sand Gas Oil Total Depth 3354

PRODUCTION

1st 24 hrs. Nat. 1st 24 hrs. after shot Gas Cu. Ft.Dry Hole Abandoned

Date

OCT 30 1940 19S. J. LEWIS Scout

Map No. 48 Sec. 30 Twp. 20 R. 5WWell No. 4 BornholdtMoulton etal Company

Contractor

FIRST REPORT

C S L NW SE

990 Ft. from N. Line Ft. from S. Line Ft. from E. Line660 Ft. from W. Line

BORNHOLDT POOL

SECTION PLAT

Location Rig up

Drilling and Remarks:

OWDD-OTD 3354

T.D. 3365

Pay 3362-65

Flow 140 bbls.P.H.

RECORD

Cased in., ft.Sand Gas Oil Total Depth

PRODUCTION

1st 24 hrs. Nat. 1st 24 hrs. after shot Gas Cu. Ft.Dry Hole Abandoned

Date

NOV 6 1940 19 S. J. LEWIS Scout

Map No. 48 Sec. 30 Twp. 20 R. 5WWell No. 4 BornholdtMoulton etal Company

Contractor

COMPLETED

C S L NW SE

990 Ft. from N. Line Ft. from S. Line Ft. from E. Line660 Ft. from W. Line

BORNHOLDT POOL

SECTION PLAT

Location Rig up

Drilling and Remarks:

OWITT
CT 3354
Pay 3362-65
Born & P. 85610

Max 3000

RECORD

Cased in., ft.Sand Gas Oil Total Depth 3365

PRODUCTION

1st 24 hrs. Nat. 1st 24 hrs. after shot Gas Cu. Ft.Dry Hole Abandoned

Date

NOV 13 1940 19S. J. LEWIS

Scout