

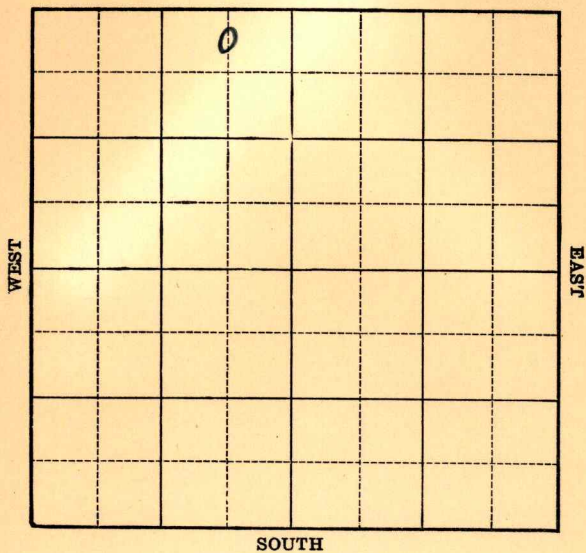
Form 51-5M-7-39-Palace

Section 30 Township 20 Range 5-W

Well No. #1 Knackstedt

Company Continental

NORTH Bornholdt Pool



Sec. 30 Twp. 20 R. 5-W

Well No. #1 Knackstedt Farm

Continental Company

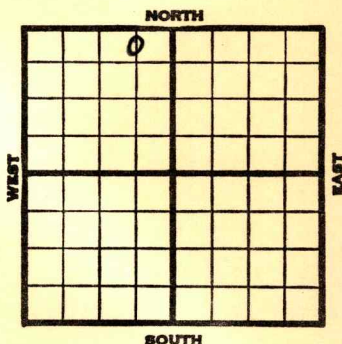
(Bornholdt)

330 Ft. from N. Line

_____ Ft. from S. Line

660 Ft. from E. Line

_____Ft. from W. Line

[illegible]

Map No. 48 Sec. 30 Twp. 20 R. 5WWell No. 1 KnackstedtContinental

Company

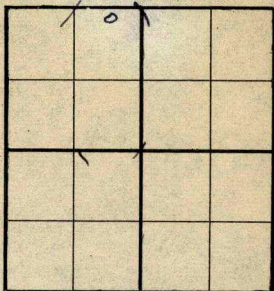
Contractor

FIRST REPORT**C N L NE NW**330 Ft. from N. Line

Ft. from S. Line

660 Ft. from E. Line

Ft. from W. Line

SECTION PLAT**BORNHOLDT POOL**

Location _____

Rig up _____

Drilling and Remarks:

Derrick**RECORD**

Cased _____ in., _____ ft.

Sand _____

Gas _____

Oil _____

Total Depth _____

PRODUCTION

1st 24 hrs. Nat. _____

1st 24 hrs. after shot _____

Gas _____ Cu. Ft.

Dry Hole _____

Abandoned _____

Date

MAR 13 1940

19

S. J. LEWIS

Scout

Map No. 48 Sec. 30 Twp. 20 R. 5WWell No. 1 Knackstedt
Continental

Company

Contractor

COMPLETED

SECTION PLAT

C N L NE NW

330 Ft. from N. Line

Ft. from S. Line

660 Ft. from E. Line

Ft. from W. Line

BORNHOLDT POOL

Location

Rig up

Drilling and Remarks:

*Cha 3278**6" 3278.**Bornholdt 1370*

RECORD

Cased _____ in., _____ ft.

Sand _____

Gas _____

Oil _____

Total Depth 3345

PRODUCTION

1st 24 hrs. Nat. _____

1st 24 hrs. after shot _____

Gas _____ Cu. Ft.

Dry Hole _____

Abandoned _____

Date

MAY 1 1940 19

S. J. LEWIS Scout