

KANSAS

Form 51—5M—11-38—Palace


McPherson

Section 30 Township 20 Range 5-W

Well No. #1 Knackstadt

Company H. C. Bennett

NORTH Barnholdt Pool

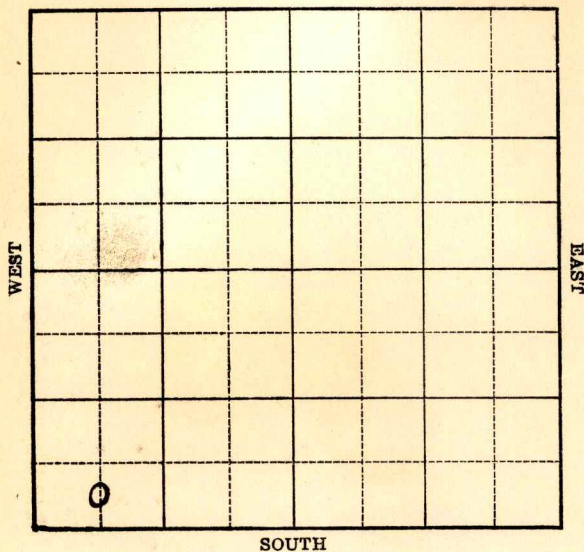

Map No. _____ Sec. 30 Twp. 20 R. 5WWell No. 1 KnackstedtH. C. Bennett

Company _____

Contractor _____

FIRST REPORT

C S L SW SW

SECTION PLAT

_____ Ft. from N. Line

330 Ft. from S. Line

_____ Ft. from E. Line

660 Ft. from W. Line

BARNHOLDT POOL

Location _____

Rig up _____

Drilling and Remarks:

Rotary

RECORD

Cased _____ in., _____ ft.

Sand _____

Gas _____

Oil _____

Total Depth _____

PRODUCTION

1st 24 hrs. Nat. _____

1st 24 hrs. after shot _____

Gas _____ Cu. Ft.

Dry Hole _____

Abandoned _____

Date

SEP 20 1939 19S. J. LEWIS

Scout

Map No. 48 Sec. 30 Twp. 20 R. 5WWell No. 1 KnackstedtH. C. Bennett

Company


Contractor

COMPLETED**C S L SW SW**

Ft. from N. Line

330 Ft. from S. Line

Ft. from E. Line

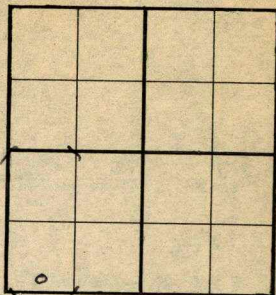660 Ft. from W. Line**BARNHOLDT POOL****SECTION PLAT**

Location _____

Rig up _____

Drilling and Remarks:

*Chat 3323**7" @ 3325**Pump 454 ft***RECORD**

Cased _____ in., _____ ft.

Sand _____

Gas _____

Oil _____

Total Depth 3369**PRODUCTION**

1st 24 hrs. Nat. _____

1st 24 hrs. after shot _____

Gas _____ Cu. Ft.

Dry Hole _____

Abandoned _____

Date

NOV 1 1939 19

S. J. LEWIS Scout