

KANSAS

Form 51—5M—7-39—Palace

McPherson

Section 30 Township 20 Range 5-W

Well No. #3 Knackstedt


Company Continental

Bornholdt Pool

NORTH

WEST

EAST

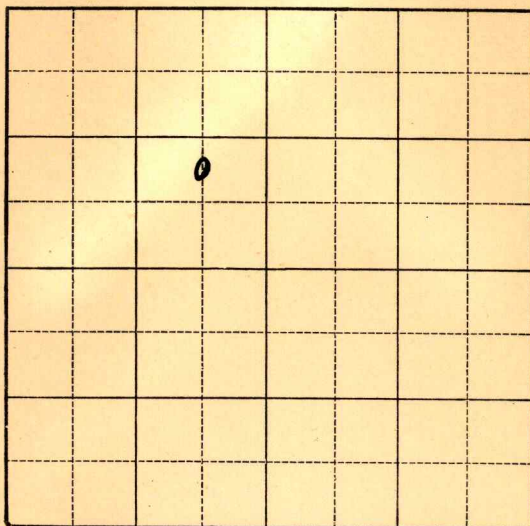

SOUTH

KANSAS

McPherson

Sec. 30 Twp. 20 R. 5-WWell No. #3 Knackstedt Farm

Continental

Company


(Bornholdt)

Ft. from N. Line

990 Ft. from S. Line660 Ft. from E. Line

Ft. from W. Line

Elev. 1525

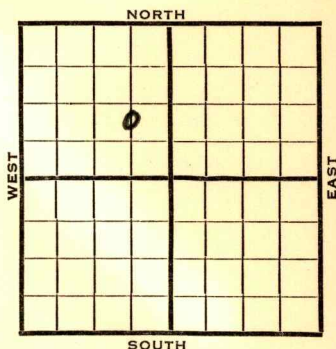


1940	REPORT
5/29	Derrick.
6/6	"
6/13	10" - 162' WOC.
6/20	Drlg. 2660'
6/27	Chat. 3286-88' T.D. 6" - 3286'
	RUST.
7/3	3312' flow 57 bbls. 6 hours.
	3330' flow 56 bbls. 1 hour.
	SD 3348'
7/10	Chat. 3286'
	6" - 3286'
	T.D. 3352'
	Potential 382 bbls., flow.

COMPLETED

Map No. 48 Sec. 30 Twp. 20 R. 5WWell No. 3 KnackstedtContinental Company

Contractor

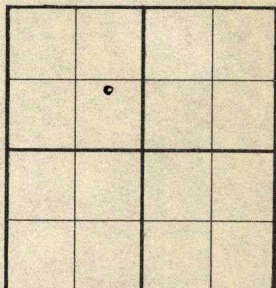FIRST REPORT
C N L SE NW**SECTION PLAT** Ft. from N. Line990 Ft. from S. Line660 Ft. from E. Line Ft. from W. Line**BORNHOLDT POOL**Location Rig up

Drilling and Remarks:

Derrick**RECORD**Cased in., ft.Sand Gas Oil Total Depth **PRODUCTION**1st 24 hrs. Nat. 1st 24 hrs. after shot Gas Cu. Ft.Dry Hole Abandoned

Date

MAY 29 1940 19S. J. LEWIS Scout

Map No. 48 Sec. 30 Twp. 20 R. 5WWell No. 3 KnackstedtContinental CompanyContractor

COMPLETED

SECTION PLAT

C N L SE NW

 Ft. from N. Line990 Ft. from S. Line660 Ft. from E. Line Ft. from W. Line

	o		

BORNHOLDT POOL

Location Rig up

Drilling and Remarks:

*Cha 83286**6" C 3286.**Flow 382 Rx.*

RECORD

Cased in., ft.Sand Gas Oil Total Depth 3352

PRODUCTION

1st 24 hrs. Nat. 1st 24 hrs. after shot Gas Cu. Ft.Dry Hole Abandoned

Date

JUL 10 1940 19S. J. LEWIS Scout