

# KANSAS

Form 51-5M-7-40-Palace


McPherson

Section 30 Township 20 Range 5-W

Well No. #3 Knackstedt

Company E. K. Carey

Bornholdt Pool

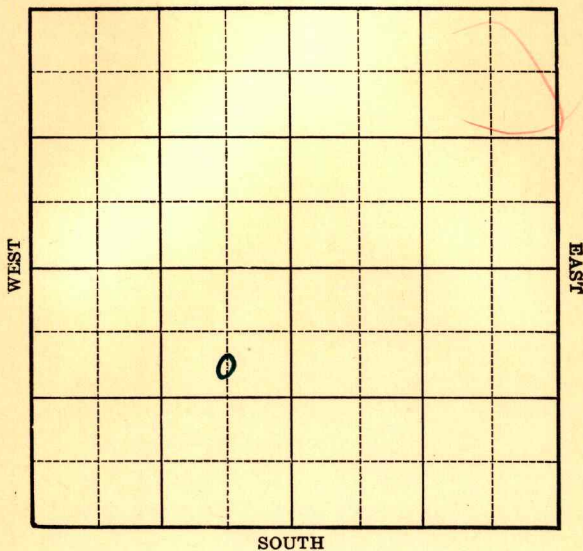

Sec. 30 Twp. 20 R. 5-W

Well No. #3 Knackstedt Farm

E. K. Carey Company

(Bornholdt)


990 Ft. from N. Line

Ft. from S. Line

660 Ft. from E. Line

Ft. from W. Line

**Elev. 1522**

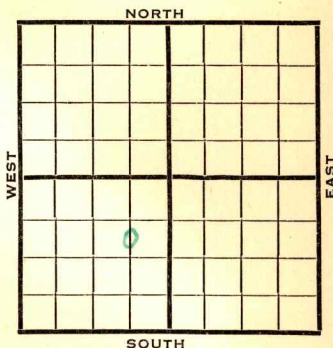

1940	REPORT
8/14	Derrick.
8/22	110' of 10"
	Drlg. 1100'
8/29	Drlg. 3242'
9/5	<b>Chat. 3283'</b> 5" - 3285'
	T.D. 3323' Flow 311 bbls. 1 hr
9/12	" " " " "
9/18	<b>Chat. 3283'</b>
	5" - 3285'
	T.D. 3323'
	Bomb potential 83,262 bbls.
	Maximum 3000 bbls.
	<b>COMPLETED</b>

Map No. 48 Sec. 30 Twp. 20 R. 5W

Well No. 3 Knackstedt

E. K. Carey Company

Contractor

C S L N E S W

SECTION PLAT

990 Ft. from N. Line

\_\_\_\_\_ Ft. from S. Line

660 Ft. from E. Line

\_\_\_\_\_ Ft. from W. Line

BORNHOLDT POOL


Location \_\_\_\_\_

Rig up \_\_\_\_\_

Drilling and Remarks:  
**Derrick**

RECORD

Cased \_\_\_\_\_ in., \_\_\_\_\_ ft.

Sand \_\_\_\_\_

Gas \_\_\_\_\_

Oil \_\_\_\_\_

Total Depth \_\_\_\_\_

PRODUCTION

1st 24 hrs. Nat. \_\_\_\_\_

1st 24 hrs. after shot \_\_\_\_\_

Gas \_\_\_\_\_ Cu. Ft.

Dry Hole \_\_\_\_\_

Abandoned \_\_\_\_\_

Date

AUG 14 1940 19

S. J. LEWIS Scout

Map No. 48 Sec. 30 Twp. 20 R. 5W

Well No. 3 Knackstedt

E. K. Carey Company

Contractor

COMPLETED

SECTION PLAT

C S L N E SW

990 Ft. from N. Line

Ft. from S. Line

660 Ft. from E. Line

Ft. from W. Line


BORNHOLDT POOL

Location \_\_\_\_\_

Rig up \_\_\_\_\_

Drilling and Remarks:

*Chas 3283*  
*5" @ 3285*  
*Bornholdt 83262*

*May 3000*

RECORD

Cased \_\_\_\_\_ in., \_\_\_\_\_ ft.

Sand \_\_\_\_\_

Gas \_\_\_\_\_

Oil \_\_\_\_\_

Total Depth 3323

PRODUCTION

1st 24 hrs. Nat. \_\_\_\_\_

1st 24 hrs. after shot \_\_\_\_\_

Gas \_\_\_\_\_ Cu. Ft.

Dry Hole \_\_\_\_\_

Abandoned \_\_\_\_\_

Date

SEP 18 1940

19

S. J. LEWIS Scout