

DX 78-1


Rice

**KANSAS**

Section 31 Township 20 Range 6W

Well No. #1 Brothers J

Company R F. Raymond

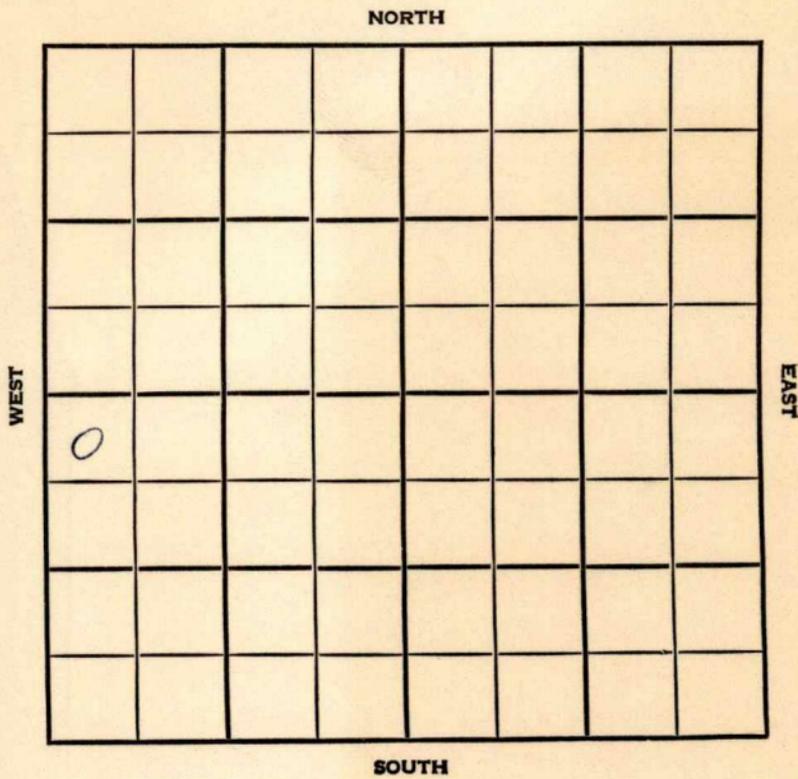

Rice

KANSAS


SEC. 31	TWP. 20	R. 6W
------------	------------	----------

WELL NO. #1 Brothers "J" FARM

COMPANY F. Raymond

CONTRACTOR Tom Allen

N. Wherry  
 \_\_\_\_\_ FT. FROM N. LINE  
 \_\_\_\_\_ FT. FROM S. LINE  
 \_\_\_\_\_ FT. FROM E. LINE  
 \_\_\_\_\_ FT. FROM W. LINE

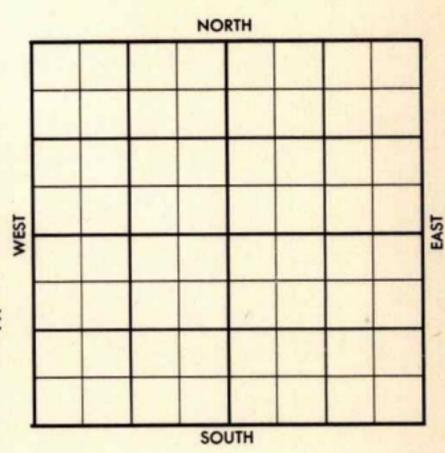

NW NW SW

1956	ELEVATION 1685'	REPORT
------	--------------------	--------

5-29 Location  
 6-6 Spud 5-31-56  
 8" @239 w/200  
 Drlg. 3105'  
 6-13 RTD 3433  
 5 1/2" @3432  
 6-20 CO 3432  
 DD 3467  
 No show  
 Frac, lost load  
 D & A  
 H. 2748', B.L. 2915', L. 2940',  
 B.K.C. 3303', Cgl 3431', M. 3460'  
 TD 3433'  
**ABANDONED**

County Rice Elev. 1685  
 Sec. 31 Temp. 20 Rge. 6W  
 Company F. Raymond  
 Farm Name B rothers J No. 1

TOPS	DEPTH	LOG	DATUM	Loc. in Sec.
Anh.				NW NW SW
Tr.				
Dg.				
Bl.	<u>2748</u>			
L.	<u>2915</u>			
K.C.	<u>2940</u>			Geol.
B.K.C.	<u>3303</u>			Contr.
Ce. <u>291</u>	<u>3431</u>			<u>Ton Allen</u>
C.				Pool
M.	<u>3460</u>			<u>N. Wherry</u>
M.				
K.				
Mz.				
Mo.				
V.				
S.				
S.				
A.				
R.				
PE.				
G.				
TD.	<u>3433</u>			

ABANDONED

Date Comm. JUN 20 1956  
 Location JUN 6 '56 Spd 5-31-56  
8" 239/200 2105 JUN 13 '56  
RTD 3433 5 1/2" 3432 JUN 20 '56  
CO 3432 DD 3467 no show  
FRAC Lost Load

DEA

