

KANSAS


Rice

Section 31 Township 20 Range 6W

Well No. 1 Moll

Company Hinkle & Apex

Wildcat

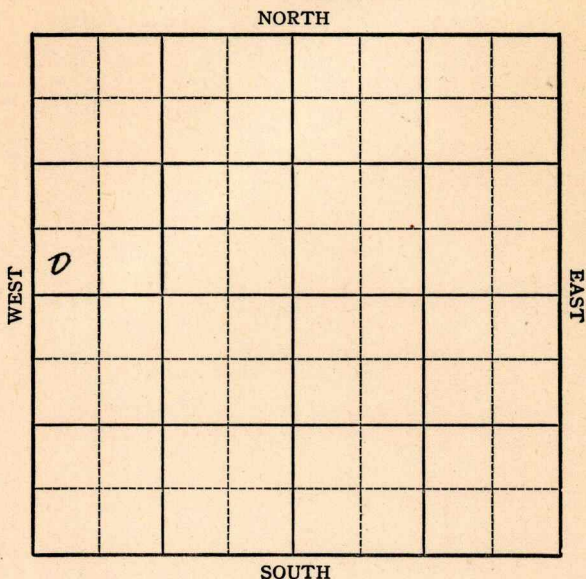

KANSAS

Rice

Sec. 31 Twp. 20 R. 6W ✓


Well No. #1 Moll _____ Farm _____

Hinkle & Apex

Company

Wildcat (Hinkle, Cont.)

NORTH

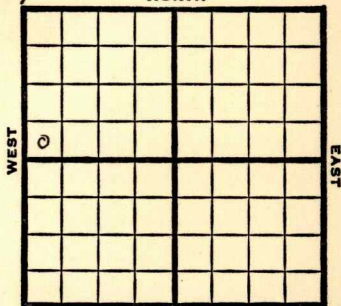

_____ Ft. from N. Line

330' Ft. from S. Line

_____ Ft. from E. Line

330' Ft. from W. Line

SW NW

SOUTH

1949

Elev 1676'

REPORT

6/1

8" @ 169'

Drlg. 2005'

6/7

Lansing 2913'

Cong 3395'

TD 3410'

SO

6/15

5"@ 3404'

TD 3420'

1100' oil

6/21

Swb 30 bbls oil / 4 W A Day

6/29

TD 3450'

Miss 3424'

Went to wtr.

Aband.

ABANDONED

Kansas

Map No. _____ Sec. 31 Twp. 20 R. 6WWell No. 1 MollHinkle & Apex CompanyHinkle Contractor


SW NW

FIRST REPORT
SECTION PLAT

_____ Ft. from N. Line

330 Ft. from S. Line

_____ Ft. from E. Line

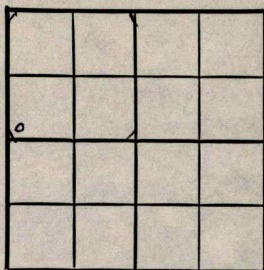330 Ft. from W. LineRice County

Location _____

Rig up _____

Drilling and Remarks:

8" @ 169

drlg. 2005

RECORD

Cased _____ in., _____ ft.

Sand _____

Gas _____

Oil _____

Total Depth _____

PRODUCTION

1st 24 hrs. Nat. _____

1st 24 hrs. after shot _____

Gas _____ Cu. Ft.

Dry Hole _____

Abandoned _____

Date

JUN 1 1949 19 S. J. LEWIS Scout

Map No. K48 Sec. 31 Twp. 20 R. 6W

Well No. 1 Moll

Hinkle & Apex Company

ABANDONED

Contractor

SW NW

E 1/6 76
SECTION PLAT

o			

 Ft. from N. Line

330 Ft. from S. Line

 Ft. from E. Line

330 Ft. from W. Line

Rice County

Location

Rig up

Drilling and Remarks:

Miss 3424
Went & dewater.

RECORD

Cased in., ft.

Sand

Gas

Oil

Total Depth 3450

PRODUCTION

1st 24 hrs. Nat.

1st 24 hrs. after shot

Gas Cu. Ft.

Dry Hole

Abandoned

Date

JUN 29 1949

19

S. J. LEWIS

Scout