FORM 51

Rice KANSAS

Section 31 Township 20 Range 6 W

Well No. # 1 A. B. Mott

Company Stag Drlg.

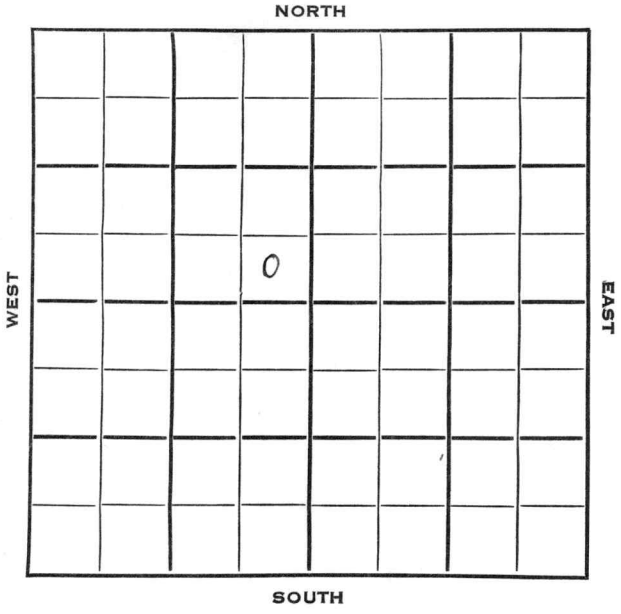

Rice KANSAS

SEC.	TWP.	R.
31	20	6 W

WELL NO. # 1 A. B. Mott FARM

COMPANY Stag Drlg.

CONTRACTOR Stag Drlg.

_____ Ft. from N. Line

330 Ft. from S. Line

330 Ft. from E. Line

_____ Ft. from W. Line

SE SE NW

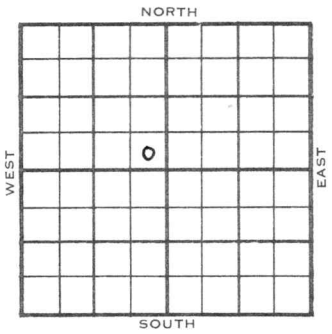

CRA & Sunray - DHM

1954	ELEVATION REPORT
5/12	Spud 4-29-54 D & A TD 3468' 8" @ 140 Heeb 2726 KC 2921' Cong. 3402' Miss 3436 DST 3439-55, open ½ hr rec 6' mud 0# TD 3468' D & A FIRST REPORT ✓ ABANDONED

DX-78

FORM 275 FOR SALE BY KANSAS BLUE PRINT CO.

County Rice State Kansas

Sec. 31 (Blk. Twp.) 20 (Sur. Rge.) 6W Map No.

Operator Stag Drlg.

Well No. 1 Farm A. B. Mott

Elev. Location SE SE NW



330 Ft. From S Line NW

330 Ft. From E Line Quarter

1st. Report MAY 12 1954

Completion MAY 12 1954

Remarks CRA & Sunray - DHM
Stag Drlg. - Contr.

Spudding Date 4-29-54

Drlg. Data D & A TD 3468

8" @ 140 Heeb. 2726 KC 2921

Cong. 3402 Miss. 3436 DST 3439-55

open ½ hr. Rec. 6' mud 0# TD 3468

D & A

J. G. McGEHEE